

CERTIFIED LAND CORNER RESTORATION

Index No. **X-3**

State of Wisconsin

County of Oneida } ss.



I, Philip T. Hansen, do hereby certify that on the 7th day of August, 1978, I found evidence of the C 1/4 corner of Section 31 Township 38 North, Range 11 East, Fourth Principal Meridian, as described hereon; and that from this evidence I established a new monument and accessories as described hereon to perpetuate the original location of this corner.

Resident witnesses:

Jim Claffin

Herb Wagoner

John Masbaum

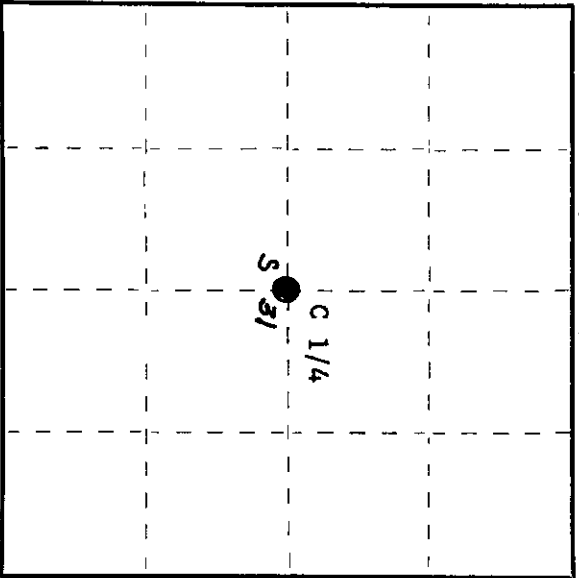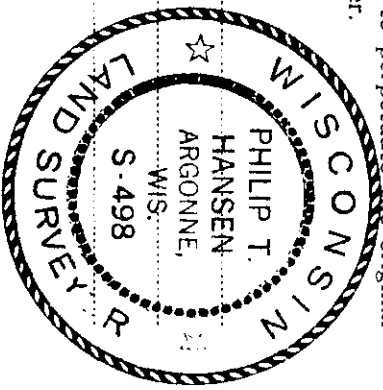

○ = Corner monument restored.

History of original corner establishment:

Corner established by N. Loftus, Ripco Surveyor. Ran random line west 271° 21' magnetic from E 1/4 corner 87.31 chains to close out 68 1/2 links south of W 1/4 corner. Set C 1/4 corner at 31.4 links north at 40.05 chains. Marked NBT - Elm 8" N79°E, 2.61 chains.

Description of corner evidence found:

Recovered Ripco's 2 1/2" iron pipe with 5" square brass cap in good condition. Corner sets off an old stub road in Branham's field which is now planted to red pine. OBT - Elm 8" N79°E, 2.61 chains is no longer visible. Monument projects 2' above ground, cap stamped:

T38N R11E  
C 1/4 S 31  
RIPCO

Description of monument and accessories I established to perpetuate the original location of this corner.

As monument was recovered in good condition, it was left in place as recovered.

- Marked NBT's - red pine 8" S75°E 14.8 links
- red pine 7" N22°E 38.4 links
- w. spruce 7" S52°W 50.4 links
- All Scribbled C 1/4 BT.

Dated at Rhineland, Wis., this 14th day of August, 1978

Signature: Philip T. Hansen Title: Registered Land Surveyor Registration No. S-498  
(County Surveyor, Registered Land Surveyor, or other duly authorized official)

Office of Register of Deeds, County of Oneida, I hereby certify that the within instrument was filed in this office for record on the 21st day of August, 1978 at 1:00 o'clock P.M.

Doris George Fuchs  
(Register of Deeds)

By: \_\_\_\_\_ Deputy

381131200