

CERTIFIED LAND CORNER RESTORATION

Index No. **W-5**



State of Wisconsin

County of **Oneida** } ss.

I **Phillip T. Hansen**, do hereby certify that on the **18th** day of **April**, 19**78**, I found evidence of the **N 1/16** corner of **Sections 31 & 32** Township **38** North, Range **11 East**, Fourth Principal Meridian, as described hereon; and that from this evidence I established a new monument and accessories as described hereon to perpetuate the original location of this corner.

Resident witnesses:

Jim Clafin
John Masbaum

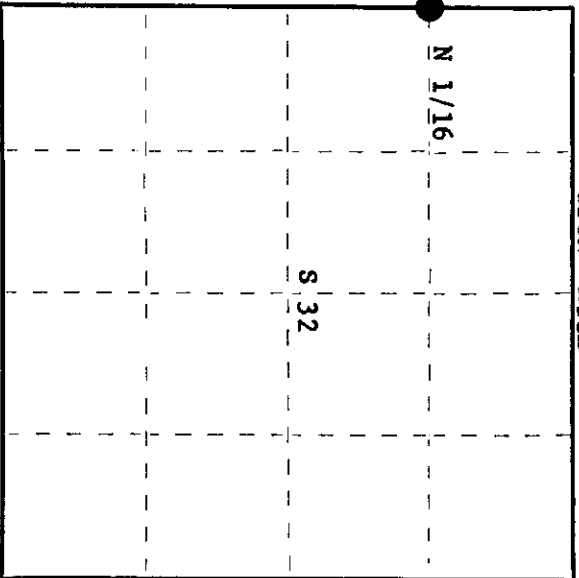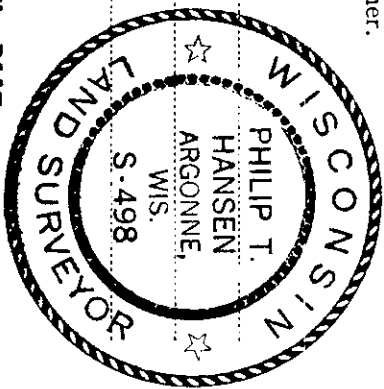

○ = Corner monument restored.

History of original corner establishment:

Corner established by **D.H. Vaughan**.
Corner recovered in 1958 by **N. Loftus**, Ripco surveyor, in 1958.
Set new pine and marked NBT's -
Oak 5" N45°E, 49½ links
Aspen 8" S26°W, 47½ links

Description of corner evidence found:

Recovered 3/4" iron pipe with 2" squared brass cap, stamped:
Pipe projects 16" above ground.
Recovered OBT's -
Red Oak 5" (7") N45°E, 49.5 links
scribing grown over
Aspen 8" (10") S26°W, 47.5 links
scribing grown over

Description of monument and accessories I established to perpetuate the original location of this corner.

NBT's - Red Pine 6" S74°W, 86.5 links
scribing 1/16 BT

Dated at **Rhineland**, Wis., this **18th** day of **May**, 19**78**.

Signature *Phillip T. Hansen* Title **Registered Land Surveyor** Registration No. **S-498**
(County Surveyor, Registered Land Surveyor, or other duly authorized official)

Office of Register of Deeds, County of **Oneida**
Instrument was filed in this office for record on the **28th** day of **May**, 19**78** at **1:00** o'clock **P.** M.

Doree Verage Fuchs
(Register of Deeds)

By: _____ Deputy

3811313000