

CERTIFIED LAND CORNER RESTORATION



Index No. **A-9**

State of Wisconsin }
County of Oneida } ss.

I, Phillip T. Hansen, do hereby certify that on the 21st day of February, 1978, I found evidence of the Section Corner corner of Sections 4, 5, 32, 33 Township 37 & 38, North, Range 11 East, Fourth Principal Meridian, as described hereon; and that from this evidence I established a new monument and accessories as described hereon to perpetuate the original location of this corner.

Resident witnesses:

- Glen Barker
- Jim Clafin
- Herb Wagoner

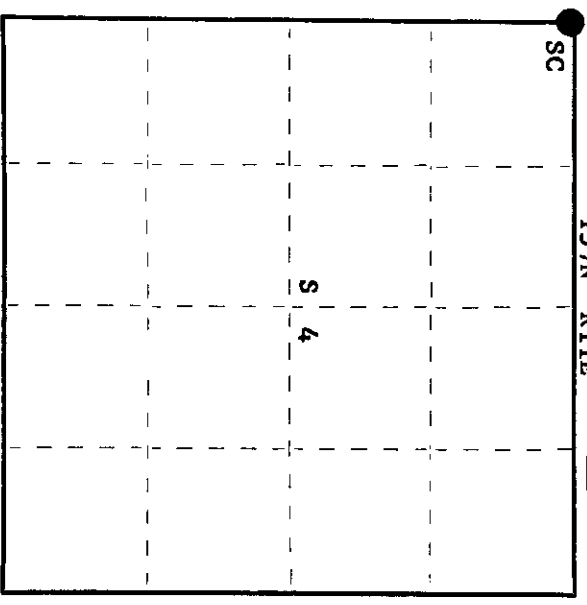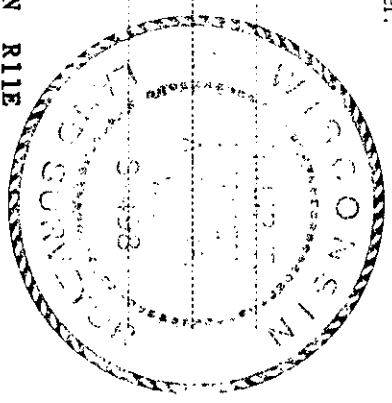

○ = Corner monument restored.

History of original corner establishment: Original corner established by Hiram C. Fellows, Government Deputy Surveyor, in 1859, from which tamarack 6" bears N55°W, 11 links; tamarack 6" N41°E, 40 links; tamarack 6" S39°E, 19 links; tamarack 6" S43°W, 28 links.

Corner recovered by J.J. Melendy, Registered Land Surveyor, in 1910. Found old post 3" x 3" x 5', 4 notches on east side, 2 notches on west side, point in ground sound and preserved in water from which old tamarack BT stumps bear NW 25 links - SE 30 links - SW 20 links - NE 33 links.

Corner recovered by V. Maine, county surveyor, in 1935. Identified by 3 old points. Set a 2 1/2" iron pipe with brass cap in place of old point. Corner recovered by H.C. Lawrence, Registered Land Surveyor, in 1949. NBT - white pine 5" S75°E, 147 links.

Description of corner evidence found:

- Recovered Maine's 2 1/2" iron pipe with brass cap, stamped: T38N R11E
- Projects 18" above ground. 32+33
- Also H.C. Lawrence's 5" jack pine post, squared and scribed 5+4
- S32, S5, S4, S32, standing beside iron pipe.
- Recovered H.C. Lawrence's white pine 5" (7") S75°E, 147 links, T37N R11E
- scribed S5 - NBT.

Description of monument and accessories I established to perpetuate the original location of this corner.

- Pipe 1 1/2 in perfect condition and securely set. It was left in place.
- Corner sets in open muskeg swamp, no BT's near.
- Set three 1 1/2" x 4" iron pipe for witness corners
- #1 N45°E, 25 links
- #2 N45°W, 50 links
- #3 South 60 links
- projecting 18" above ground.

Dated at Rhineland, Wis., this 7th day of March, 1978.

Signature Phillip T. Hansen Title Registered Land Surveyor Registration No. S-498
(County Surveyor, Registered Land Surveyor, or other duly authorized official)

Office of Register of Deeds, County of Oneida
Instrument was filed in this office for record on the 13th day of March, 1978
at 2:30 o'clock P. M.

Doris Venega Kuehn
(Register of Deeds)

By: _____ Deputy

3811 320000