

Stock No. 26273

U.S. PUBLIC LAND SURVEY MONUMENT RECORD

Index No. A-25

State of Wisconsin } ss. County of Onida

I, William B. Cochran, do hereby certify that on the 5th day of February, 1990, I found evidence of the Northeast Section corner of Section 1, Township 37 North, Range 11 East, Fourth Principal Meridian, as described hereon; and that from this evidence I established a new monument and accessories as described hereon to perpetuate the original location of this corner.

Resident witnesses:

History of original corner establishment: Original Government Survey in 1858 by Alfred Millard. Dependent Resurvey in 1937 by Wesson Cook. West on the South boundary of Section 31, T38N R12E, at 78.77 chains, the point for the original corner of Townships 37 and 38 North, Ranges 11 and 12 East, is determined from remains of original bearing trees. Set a concrete monument, 2 feet long, 6 inches in diameter, with a brass tablet marked; T38N, R11E, R12E, S36, S31, S1, S6, T37N, 1937. From which the following bear; Cedar 5" N68°45'E 48.84 feet Cedar 5" N68°45'E 36.96 feet Cedar 5" S25°45'E 23.10 feet Cedar 6" N75°30'W 25.08 feet

Description of corner evidence found: Found monument as described and in place. Northeast and alongside monument, found a 2 inch diameter iron pipe with a threaded cap stamped to identify the corner.

Found the following bearing trees; Cedar 11" N68°45'E 49.28 feet Cedar 11" S25°45'E 23.55 feet Cedar (Stump) S42°00'W 36.96 feet Cedar (Stump) N75°30'W 25.08 feet

Description of monument and accessories I established to perpetuate the original location of this corner. Blazed and scribed the following new bearing trees;

Cedar 11" S35°W 38.70 feet Spruce 9" N16°W 14.80 feet

Set; Steel Sign Post South 1.00 feet

Painted all bearing trees and attached bearing tree signs to same.


Dated at Hills, Wis., this 5th day of February, 1990

Signature of William B. Cochran, Land Surveyor (County Surveyor, Registered Land Surveyor, or other duly authorized official) Registration No. S-1107

Office of Register of Deeds, County of Onida, I hereby certify that the within instrument was filed in this office for record on the 19th day of February, 1990 at 10:00 o'clock A.M.

(Register of Deeds)

By Deputy

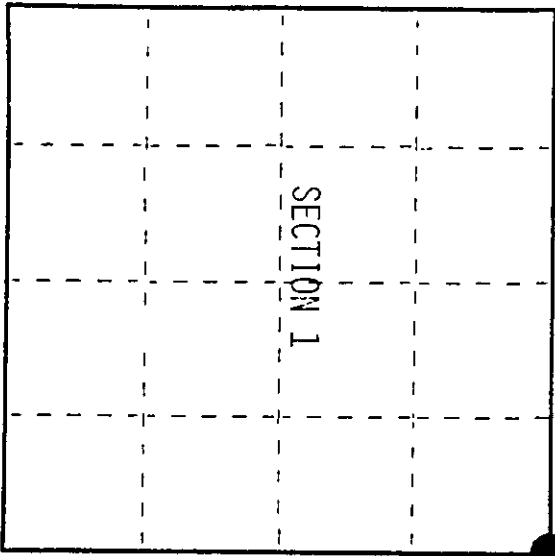

● = Corner monument restored.

000921108



Stock No. 26273

U.S. PUBLIC LAND SURVEY MONUMENT RECORD

Index No. Z-25

State of Wisconsin

County of Oneida } ss.

I, William B. Cochrane, do hereby certify that on the 5th day of February, 1990, I found evidence of the Southeast Section corner of Section 36, Township 11 East, Range 11 East, Fourth Principal Meridian, as described hereon; and that from this evidence I established a new monument and accessories as described hereon to perpetuate the original location of this corner.

Resident witnesses:

History of original corner establishment:

Original Government Survey in 1858 by Alfred Millard. Dependent Resurvey in 1937 by Wesson Cook. West on the South boundary of Section 31, T38N R12E, at 78.77 chains, the point for the original corner of Townships 37 and 38 North, Ranges 11 and 12 East, is determined from remains of original bearing trees. Set a concrete monument, 2 feet long, 6 inches in diameter, with a brass cap marked; T38N, R11E, R12E, S36, S31, S1, S6, T37N, 1937. From which the following bear:
Cedar 5" N68°45'E 48.84 feet Cedar 5" S42°00'W 36.96 feet
Cedar 5" S25°45'E 23.10 feet Cedar 6" N75°30'W 25.08 feet

Description of corner evidence found:

Found monument as described and in place. Northeast and alongside monument, found a 2 inch diameter iron pipe with a threaded cap stamped to identify the corner.

Found the following bearing trees:

Cedar	11"	N68°45'E	49.28 feet
Cedar	11"	S25°45'E	23.55 feet
Cedar (Stump)		S42°00'W	36.96 feet
Cedar (Stump)		N75°30'W	25.08 feet


Description of monument and accessories I established to perpetuate the original location of this corner. Blazed and scribed the following new bearing trees;

Cedar	11"	S35°W	38.70 feet
Spruce	9"	N16°W	14.80 feet

Set:

Steel Sign Post South 1.00 feet

Painted all bearing trees and attached bearing tree signs to same.

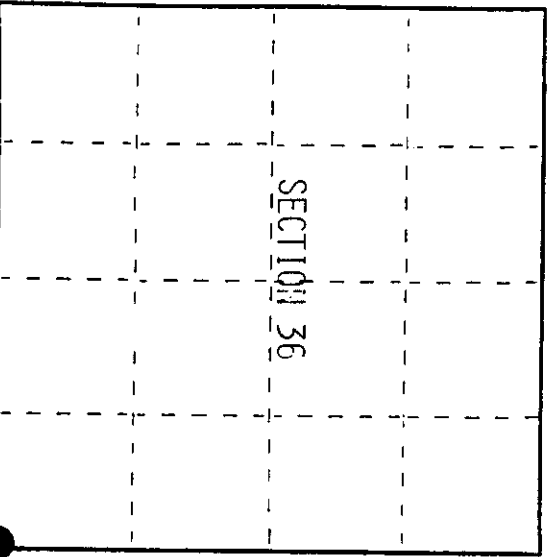

= Corner monument restored.

Dated at Hills, Wis. this 5th day of February, 1990

Signature: William B. Cochrane Title: Land Surveyor (County Surveyor, Registered Land Surveyor, or other duly authorized official) Registration No. S-1107

Office of Register of Deeds, County of Oneida, I hereby certify that the within instrument was filed in this office for record on the 19th day of February, 1990 at 10:00 o'clock A.M.

(Register of Deeds)

By: Deputy

3811360000

