

CERTIFIED LAND CORNER RESTORATION


State of Wisconsin }
County of Price } ss.


Description of original monument and accessories and subsequent restorations:
From B.L.M. Resurvey notes of 1936: Set cylindrical concrete monument 24" long, 6" dia., with 3/2" brass tablet on top marked "T39N, R3E, R4E, S1, S6, S7, S12, 1936." From which the remains of the original bearing trees: Fallen Cedar 14" brs. S42°E, 10 links; Fallen Cedar 10", brs. N48°E, 20 links; Fallen Cedar 12", brs. S51°W, 26 links; Birch stump brs. N59°W, 23 links. New bearing trees: Tamarac 4", N89 1/2°E, 60.1 feet; Tamarac 4", S76-3/4°E, 87.1 feet; W. Birch 5", S32 1/2°W, 73.3 feet; W. Birch 7", N83 1/4°W, 141.9 feet. 463 feet south, leave alder swamp.

Description of corner evidence found:
Found the 1936 B.L.M. monument, in place, in an alder swamp, leaning north. Set the monument upright, firmly in ground, extending 5" above swamp level. Found old windfall evidence of the three original cedar bearing trees at the bearing and distance given in the 1936 resurvey notes. I found the 1936 B.L.M. bearing trees as follows: W. Birch 9", N83°W, 141.9 feet, scribing visible; Rotted Tam. stump with scribe marks, 9" dia., N89°E, 60 feet; Decayed windfall Tam., 6" dia., with scribe marks, S77°E, 87 feet; Rotted W. Birch stump, S32°W, 73.3 feet.

Description of monument and accessories I established to perpetuate the original location of this corner:
Set iron sign post 0.8 feet south of corner.
Blazed and scribed a new bearing tree as follows:
W. Birch 11", N12°E, 131.2 feet.
Found an old scribed cedar post alongside of corner monument. Set this post N. and alongside of cor. monument.

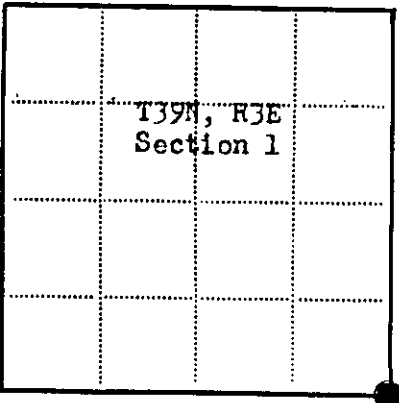

● - Corner monument restored
□ -

Resident witnesses.....
Dated at Park Falls, Wisconsin, this 19th day of November 1973.
Signature Elwood L. Olson Title Registered Land Surveyor
(County Surveyor, Registered Land Surveyor, or other duly authorized official)
Surveyors Registration No. S-785

Office of..... County of.....
I hereby certify that the within instrument was filed in this office for record on the..... day of..... 19....., and was filed in Book No..... Page No..... of County Records.

Signature..... Title.....

Township....., Range....., Section....., Index No....., Page No.....

3903010000

E-1 (39-4)

E-25