

CERTIFIED LAND CORNER RESTORATION

State of Wisconsin }
County of Oneida - PRICE } ss.

I, Elwood L. Olson, do hereby certify that on the 1st day of September, 1972, I found evidence of the Quarter corner of Sections 1 and 6 Township 39 North, Range 3 and 4 East, Fourth Principal Meridian, as described hereon; and that from this evidence I established a new monument and accessories as described hereon to perpetuate the original location of this corner:

Description of original monument and accessories and subsequent restorations:

From B.L.M. resurvey notes of 1936:
Proportionate distance, no remaining evidence of original post or bearing trees. Set iron post 3' long, 1" dia., 27" in ground, with brass cap marked: 1/4, S1, S6, 1936.
New bearing trees: W. Pine 10", N10 1/2° E, 38 links.
N. Pine 10", N38-3/4° W, 34 links.
163.7 feet S. of NE corner of Section 1.



Description of corner evidence found:

Recovered the 1936 B.L.M. brass capped iron post, in place, extending 9" above ground.
Found the 1936 B.L.M. bearing trees as follows:
N. Pine 11", with scribe marks visible, N39° W, 22.7 feet.
W. Pine 17", blaze grown over, N11° E, 24.7 feet.

Description of monument and accessories I established to perpetuate the original location of this corner:

Blazed and scribed new bearing trees as follows:

- W. Pine 16", S13° W, 11.7 feet.
- N. Pine 13", S57° W, 44.0 feet.
- Iron sign post, South, 1.3 feet.

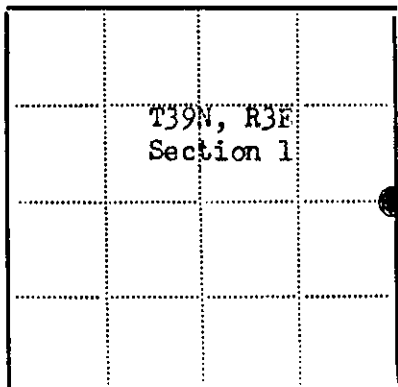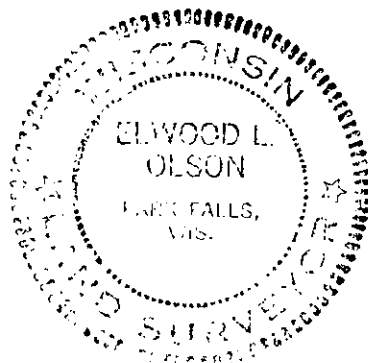

● - Corner monument restored
□ -

Resident witnesses.....

Dated at Park Falls Wisconsin, this 7th day of March 1973.

Signature Elwood L. Olson Title Registered Land Surveyor.
(County Surveyor, Registered Land Surveyor, or other duly authorized official)

Surveyors Registration No. S-785

Office of.....County of.....

I hereby certify that the within instrument was filed in this office for record on the.....day of.....19....., and was filed in Book No.....Page No.....of County Records.

Signature.....Title.....

Township....., Range....., Section....., Index No....., Page No.....

3903612000

C-1
39-4

C-25