


U.S. PUBLIC LAND SURVEY MONUMENT RECORD

Note: This form is intended and designed to fulfill all requirements of Wisconsin Administrative Code, Chapter A-E 5.02, U.S. Public Land Survey Monument Record (3) (a) (b) (c) (d) (e) (f) (g) (h) (i). An additional sheet may be added if necessary to conform with said requirements.

(a) Corner location: Township 39 North
 Range 4 East/West

Town/City/Village Minocqua

County Cneida

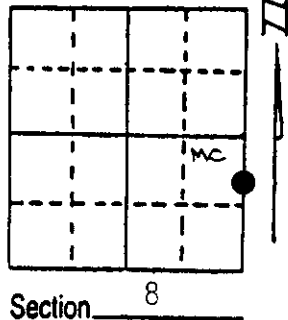


(b) (f) (g) (h) Description of monument found at this corner and if it was accepted, state all evidence (material, testimonial, occupational, plats, records, other monuments) used as a basis for accepting. If not accepted or if nothing was found, state evidence used as basis for establishing location. If reestablished through lost corner proportionate methods, indicate all monuments, distances and directions used to establish.

The original government survey was performed by Alexander Anderson in May, 1865 in which a wood post was set:
 Hemlock 14" N16°W, 35 lks.
 Hemlock 10" S89°W, 12 lks.

I found and accepted a 2" dia. iron pipe which has been used in several surveys in sections 8 and 9. I replaced the pipe with a 2-1/2" dia. 30" long aluminum pipe with a 3-1/4" dia. aluminum tablet stamped to identify its location. I established the following witnesses:

- Found 1-1/2" dia. iron pipe N36°E, 65.90 feet
- Found 2" dia. iron pipe S41°W, 94.77 feet
- Found 2" dia. iron pipe N3°E, 130.00 feet
- Set nail in W. Birch 11" N74°W, 20.93 feet
- Set plastic sign post North, 1.8 feet

(c) (d) (e) Plan view of corner with ties to at least 4 witness monuments. If in disagreement with previously established corner, show the distances between the two corners and also indicate the ties to the disputed corner.

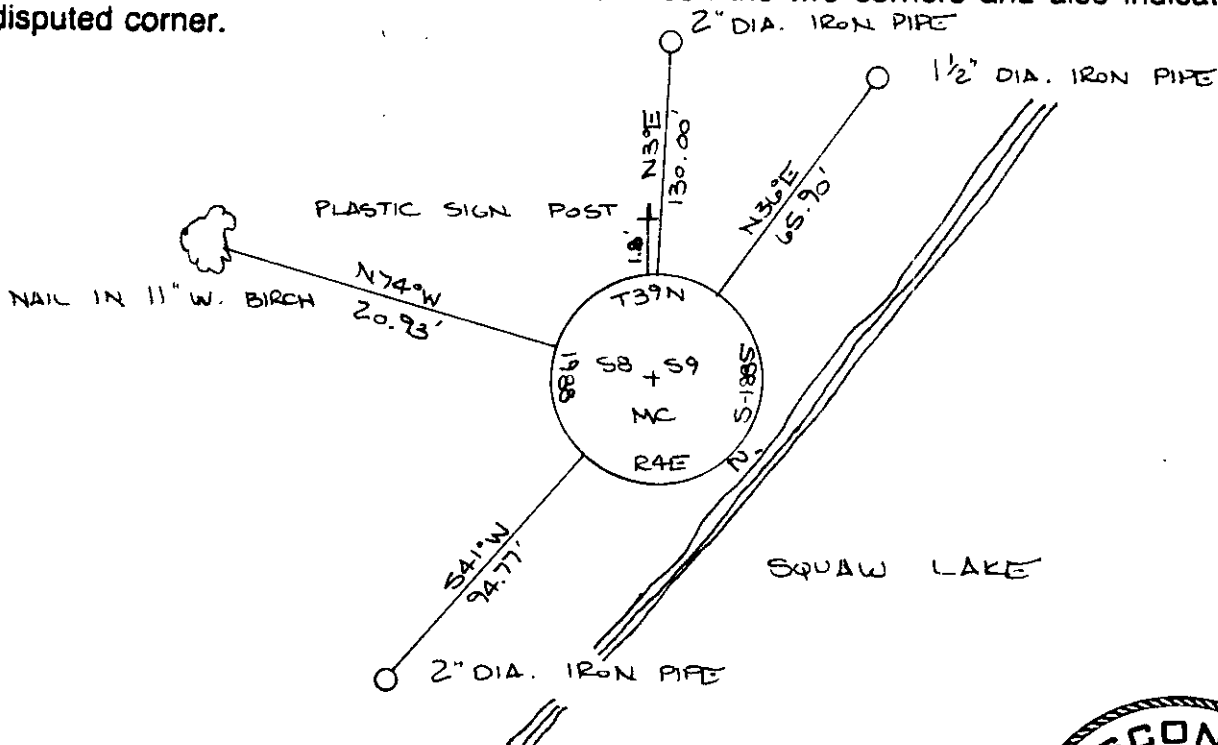

(i) I, JEFFREY W. AUSTIN S-1885
 (type or print name) certify that the corner location on this record was determined by me or under my direction and control and that this U.S. Public Land Survey Monument Record is correct and complete to the best of my knowledge and belief.

Jeffrey W. Austin
 Signature

NOVEMBER 2, 1988
 Date



Index No. GH-9

3904081400