U.S. PUBLIC LAND SURVEY MONUMENT RECORD

Note: This form is intended and designed to fulfill all requirements of Wisconsin Administrative Code, Chapter A-E 5.02, U.S. Public Land Survey Monument Record (3) (a) (b) (c) (d) (e) (f) (g) (h) (i). An additional sheet may be added if necessary to conform with said requirements.

(a) Corner location: Township 39 North

Range 4 East/~~West~~

Town/~~City/Village~~ MINOCQUA

County ONEIDA

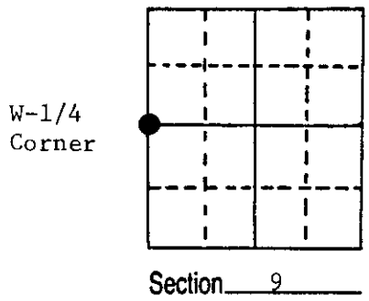

(b) (f) (g) (h) Description of monument found at this corner and if it was accepted, state all evidence (material, testimonial, occupational, plats, records, other monuments) used as a basis for accepting. If not accepted or if nothing was found, state evidence used as basis for establishing location. If reestablished through lost corner proportionate methods, indicate all monuments, distances and directions used to establish.

May 17, 1865- Alex Anderson, Deputy Surveyor: Set 1/4 Section post. Original bearing trees: Maple 10 N39°W 26 links - Hemlock 10" N84°E 14 links

Nov.19, 1930- H. C. Hall, County Surveyor: Identified original W 1/4 corner by original Hemlock and by C. D. Vaughan's 40" Birch N7°W, B.C. .34 chains

July 1964- James G. Griffin, L.S.: Survey map in Government Lot 7 identifies corner as being monumented with iron pipe, witnessed by the following bearing trees: 20" Yellow Birch N86°E, 56.3 feet - 12" Oak N79°W, 26.0 feet.

Feb.20, 1984- I found a 1" inside diameter iron pipe 1/2 inch below surface of asphalt in centerline of West Squaw Lake Road. Existing bearing tree - 29" Yellow Birch bears East, 57.50 feet. The corner position is in harmony with mon. N 1/16 corner and with County Surveyor Hall's record tie to the northwest corner of Section 9.

(c) (d) (e) Plan view of corner with ties to at least 4 witness monuments. If in disagreement with previously established corner, show the distances between the two corners and also indicate the ties to the disputed corner.

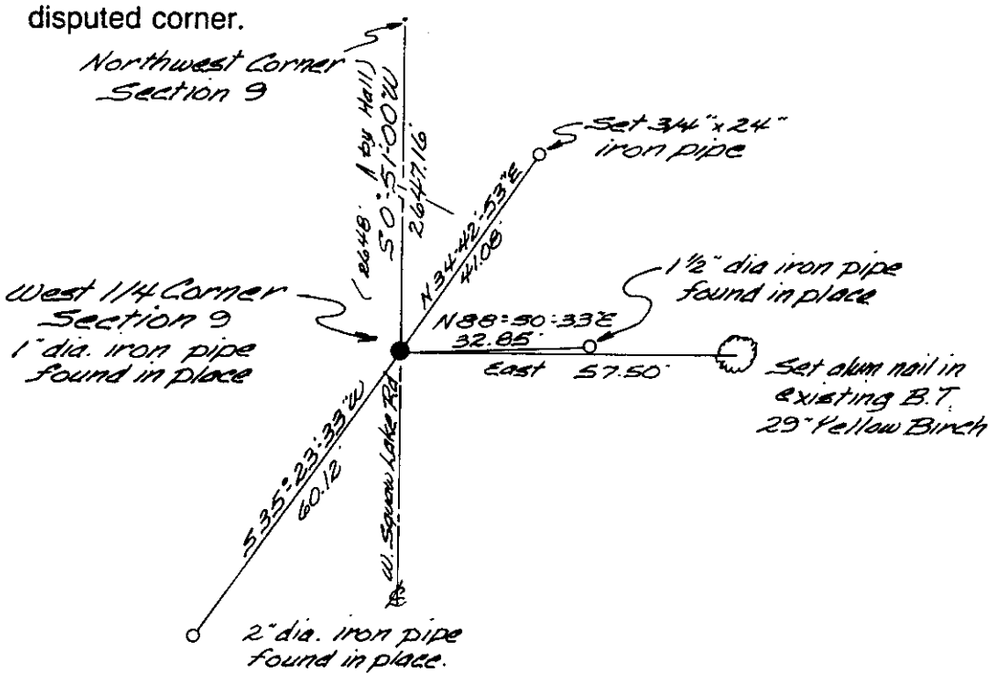

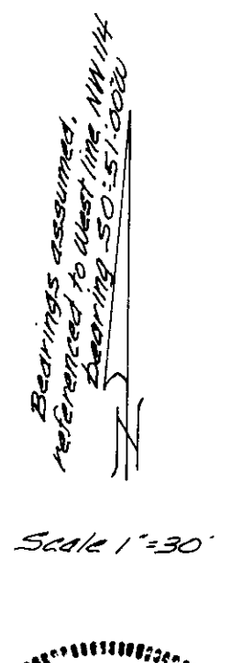

(i) I, JAMES D. REIN, Registered Land Surveyor No. S-1234 (type or print name) certify that the corner location on this record was determined by me or under my direction and control and that this U.S. Public Land Survey Monument Record is correct and complete to the best of my knowledge and belief.

James D Rein — June 21st, 1984

Signature — Date

Index No. 6-9

3904082000