

U.S. PUBLIC LAND SURVEY MONUMENT LOCATION RECORD

Recorders Data

CORNER: West 1/4 SECTION: 10 TOWNSHIP 39 NORTH RANGE 4 EAST/WEST

FOR M.C. CORNER INDICATE: NAME OF WATERWAY N/A SECTION LINE N/A

~~(CITY)~~(VILLAGE)(TOWN) OF: Minocqua COUNTY OF: Oneida

Description of monument found or placed and all other evidence used as a basis for monument location; including all monuments and related measurements required if the corner location is reestablished by lost corner proportionate methods. Also indicate name of original surveyor, survey date, corner monument set and established bearing trees, witness or reference monuments with ties from available records.

Found and accepted an old 3/4" dia. iron pipe with 90° Elbow and threaded stub 8" above existing grade at this corner location, which was also painted with blue tree marking paint as well as trees nearby. I carefully pulled the 43" long iron pipe and reset the corner with a standard 2" dia. by 30" long aluminum pipe monument with stamped Oneida County cap 3" above grade. I left the older iron pipe flat on grade nearby.


In 1865, Anderson/GLO set a wood post as the original quarter corner and marked OBTs, a 10" Hemlock N34°E 21 lks and a 12" Hemlock N47°W 18 lks, all of which are now obliterated beyond recovery for positioning purposes; however, an old rotted Hemlock stump was found NW of the corner as noted below which more than likely had been marked as a BT previously.

In 1931, H.C. Hall/Oneida County Surveyor surveyed and subdivided adjoining Section 9, and noted "orig. 1/4S" at this corner for the East 1/4 of Section 9, per his Plat of Survey filed as C-884 in Oneida County survey records; no newer BTs indicated or field notes found.

In 1976, Manson found and accepted a 3/4" dia. iron pipe at this corner and noted BTs, a 15" Maple N05°W 24.0' which I found and used for new ties and a 20" Hemlock S75°E 10.65' which I also found and used for new ties. In 1994, Foltz accepted Manson's plat of survey, filed as A-724 in Oneida County survey records, for purposes of recovering monumented corners for Lot 1. This recovery completed September 25, 1998; there were no witnesses.

Plan view map of monument location with bearing and distance ties to a minimum of four(4) described witness or reference monuments of concrete, natural stone, iron, live bearing trees or equivalent material. If applicable, also show a minimum of two(2) bearing and distance ties to any other monument found and not accepted; including the bearing and distance from the accepted monument. Indicate the basis for bearings of reference ties if not referenced to magnetic north.

NORTH

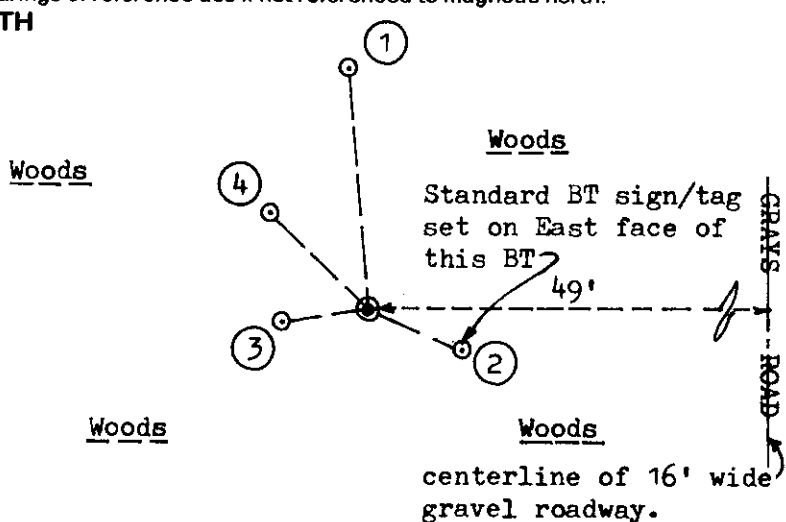

WITNESS MONUMENT TIES:

- ① Record BT now 15" Maple N05°W 25.35'; blazes shut but plain.
- ② Record BT now 20" Hemlock S65°E 10.71'; upper blaze shut/lower blaze open and plain with scribing.
- ③ New BT 16" Maple S82°W 9.26'.
- ④ New BT 14" Maple N46°W 14.50'.

Note: Probable very old 14" Hemlock rotted BT stump with faint face and scribing N34°W 16.5'.

Standard white poly 'T' marker post set 6" West of corner. I also found an old broken off 1/2" by 2 1/2" redtop poly stake which I reset on East side of corner mon.


SCALE: 1" = 20'

Unless otherwise indicated, all bearing tree ties are to a .25" dia. by 2.5" long PK nail with a 1.25" dia. steel washer stamped 'BT' is also driven into unblazed right face and a .25" dia. by 2.5" long PK nail with a 2" dia. steel washer stamped 'BT' is also driven into unblazed face of bearing tree at DBH; the basis for measured bearings is magnetic to nearest degree and all tie distances are horizontal measure to nearest 1/100th feet.

LAND SURVEYOR CERTIFICATION:

I, William C. Rohde, hereby certify that I am a duly licensed Professional Land Surveyor in Wisconsin, that this USPLS monument location was determined by me or under my direction and control, and that this U.S. Public Land Survey Monument Location Record is true and correct to the best of my knowledge and belief.

William C. Rohde Date: 9-28-98
Signature

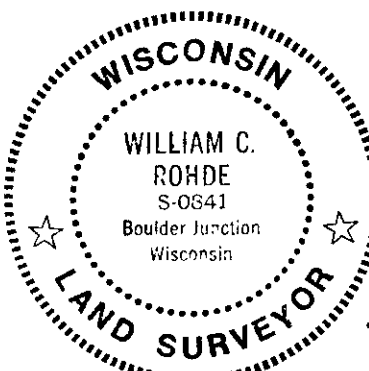

RLS SEAL

SHEET NO. 1 OF 1

This form is intended to fulfill requirements of Chapter A-E 7.08 (3)(a)(b)(c)(d)(e)(f)(g)(h)(i) U.S. Public Land Survey Monument Location Record, Wisconsin Administrative Code. Use reverse side for geodetic location data and/or continuation purposes.

	10		

SECTION LOCATION MAP

INDEX NO. G-13

3904 09 2000

INDEX NO. G-13