REGISTER OF DEEDS OFFICE
ONEIDA COUNTY, WIS.

FILED

JUN 9 2008

At ____ O'Clock ____ M

THOMAS H. LEIGHTON

U.S. PUBLIC LAND SURVEY MONUMENT RECORD

Note: This form is intended and designed to fulfill all requirements of the Wisconsin Administrative Code, Chapter A-E 7.08 U.S. Public Land Monument Record (3)(a)(b)(c)(d)(e)(f)(g)(h)(i). An additional sheet may be added if necessary to conform with said requirements.

(a) CORNER LOCATION:

North quarter corner of Section 22
Township 39 North
Range 4 East
Town of Minocqua
County of Oneida

COORDINATES

North: 246386.4611
East: 120882.9761
Control Station: 1281 (by Austin 5/8/08)
Latitude: 45°50'55.32762" N
Longitude: 89°58'26.85798" W
Datum: NAD 83 (1991) Method: RTK

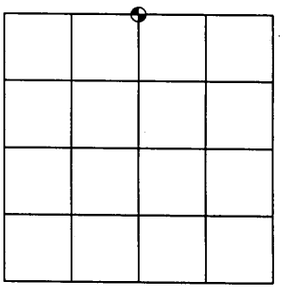

SECTION 22

(b) HISTORY OF ORIGINAL CORNER ESTABLISHMENT

Original Surveyor: Alexander Anderson
Date of Survey: Commenced May 9th, 1865
Completed May 22nd, 1865

Original B.T.'S Cedar 10" S54°E 11 links
Birch 10" N8°E 4 links

(f)(g)(h) DESCRIPTION OF MONUMENT FOUND AT THIS CORNER AND IF IT WAS ACCEPTED, STATE ALL EVIDENCE (MATERIAL, TESTIMONIAL, OCCUPATIONAL, PLATS, RECORDS, OTHER MONUMENTS) USED AS A BASIS FOR ESTABLISHING LOCATION. IF NOT ACCEPTED OF IF NOTHING WAS FOUND, STATE EVIDENCE USED AS BASIS FOR ESTABLISHING LOCATION. IF REESTABLISHED THROUGH LOST CORNER PROPORTIONATE METHODS, INDICATE ALL MONUMENTS, DISTANCES AND DIRECTIONS USED TO ESTABLISH. INDICATE TYPE OF MONUMENT AND SIGN POST FOUND OR SET.

May 12th, 2008 - James D. Rein, RLS No. 1234, searched extensively for original evidence of the corner location and find none. I re-establish the corner using single proportionate measurement and set an Oneida County capped aluminum monument and accessories as shown in plan.

(c)(d)(e) PLAN VIEW OF CORNER WITH TIES TO AT LEAST 4 WITNESS MONUMENTS. IF IN DISAGREEMENT WITH PREVIOUSLY ESTABLISHED CORNER, SHOW THE DISTANCE BETWEEN THE TWO CORNERS AND ALSO INDICATE THE TIES TO THE DISPUTED CORNER.

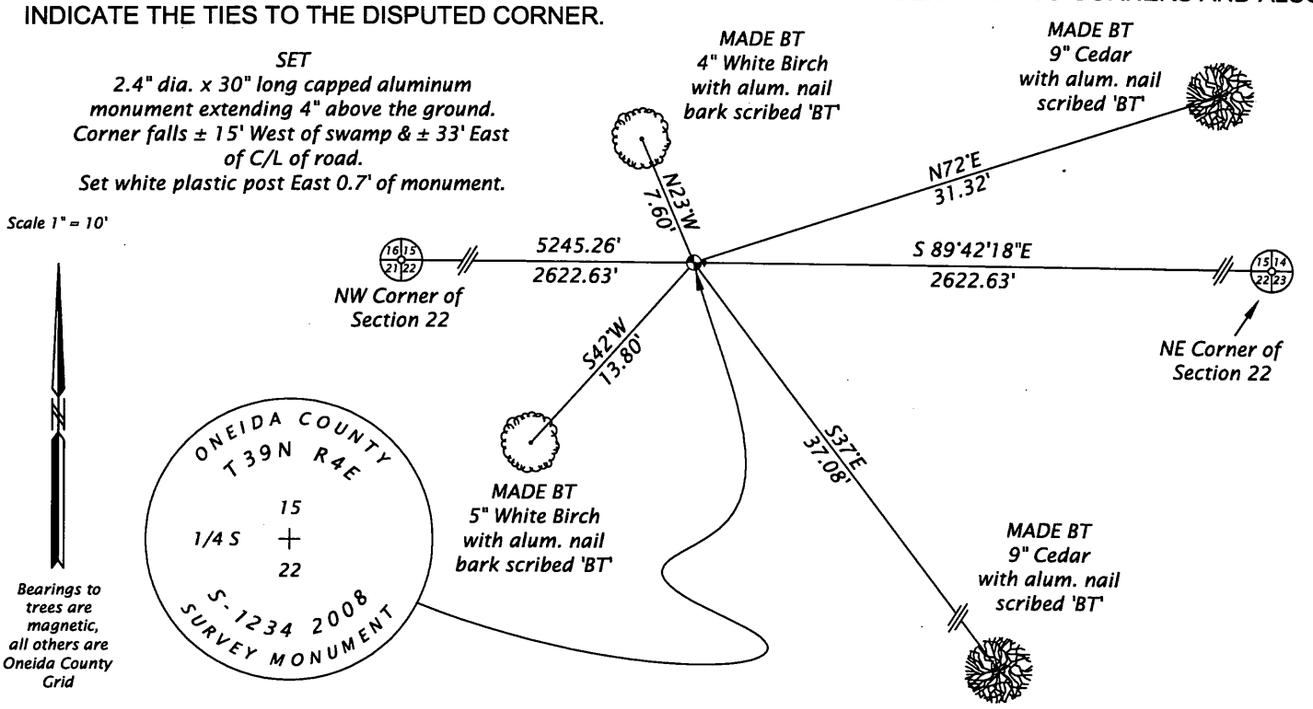

(i) I, JAMES D. REIN, REGISTERED LAND SURVEYOR NO. S-1234 HEREBY CERTIFY THAT THE CORNER LOCATION ON THIS RECORD WAS DETERMINED BY ME OR UNDER MY DIRECTION AND CONTROL AND THAT THIS U.S. PUBLIC LAND SURVEY MONUMENT RECORD IS CORRECT AND COMPLETE TO THE BEST OF MY KNOWLEDGE AND BELIEF.

SIGNATURE

6/03/08
DATE

3904150020

WISCONSIN
JAMES D.
REIN
S-1234
MINOCQUA,
WI
LAND SURVEYOR

INDEX NO. N-15