



U.S. PUBLIC LAND SURVEY MONUMENT RECORD

Note: This form is intended and designed to fulfill all requirements of Wisconsin Administrative Code, Chapter A-E 7.08 U.S. Public Land Survey Monument Record (3) (a) (b) (c) (d) (e) (f) (g) (h) (i). An additional sheet may be added if necessary to conform with said requirements.

(a) Corner location: Township 39 North
 Range 4 East/West

Town/City/Village Minocqua

County Oneida

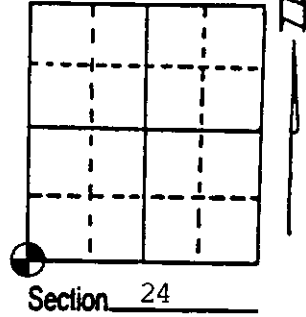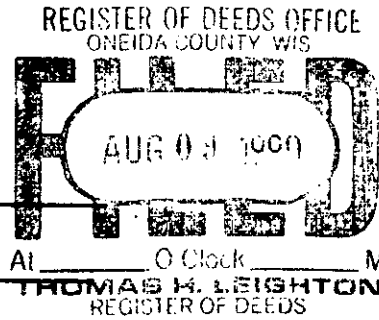

(b) (f) (g) (h) Description of monument found at this corner and if it was accepted, state all evidence (material, testimonial, occupational, plats, records, other monuments) used as a basis for accepting. If not accepted or if nothing was found, state evidence used as basis for establishing location. If reestablished through lost corner proportionate methods, indicate all monuments, distances and directions used to establish. Indicate type of monument found or set and sign post.


Original Survey by Alex Anderson, May 9, 1865 - Monument: Wood Post
 Witnesses: Hemlock 11" S57°W 27 links - Birch 8" S72°E 28 links.

I found an old scribed cedar post, iron pipe, an aluminum tag on a tree dated 1942, a nearly closed scribed 9" Y. Birch Bt. S58°E 18.4', two possible Hemlock Bt's grown shut, and a rotted Hemlock stump that fits the Gov't. Hemlock Bt. This corner also fits the Gov't swamp and high ground call from the east perfectly.

I replaced the iron pipe with a County Berntsen Mon. and Plastic Post.

(c) (d) (e) Plan view of corner with ties to at least 4 witness monuments. If in disagreement with previously established corner, show the distances between the two corners and also indicate the ties to the disputed corner.

Note: measured to the head of 6" nails.

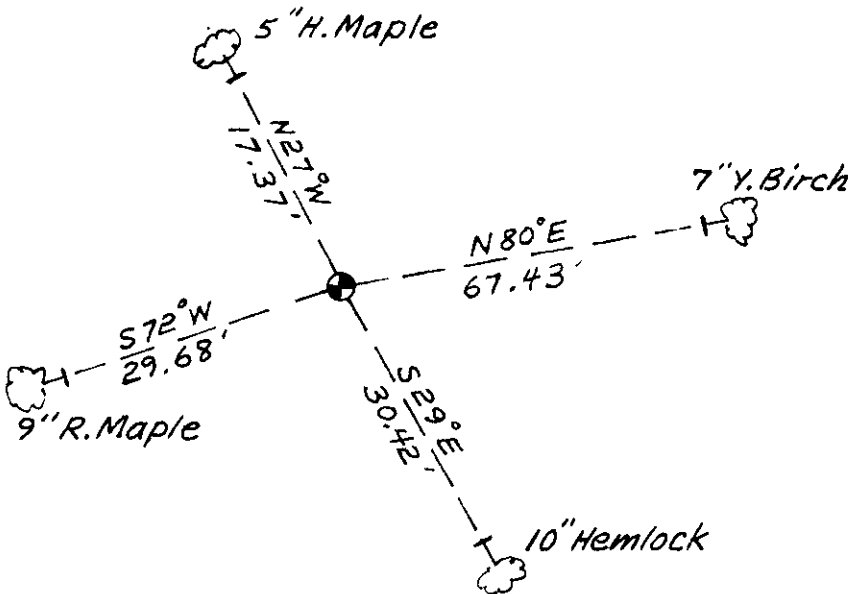

(i) I, William H. Stuth, RLS No. S-1418
 (type or print name) certify that the corner location on this record was determined by me or under my direction and control and that this U.S. Public Land Survey Monument Record is correct and complete to the best of my knowledge and belief.

William H. Stuth June 28, 1990
 Signature Date



Index No. R - 21

Stamp

3904230000