



U.S. PUBLIC LAND SURVEY MONUMENT RECORD

Note: This form is intended and designed to fulfill all requirements of Wisconsin Administrative Code, Chapter A-E 7.08 U.S. Public Land Survey Monument Record (3) (a) (b) (c) (d) (e) (f) (g) (h) (i). An additional sheet may be added if necessary to conform with said requirements.

(a) Corner location: Township 39 North
 Range 4 East/West

Town/City/Village Minocqua


County Oneida

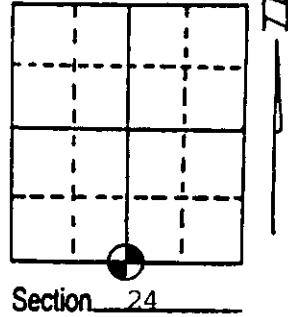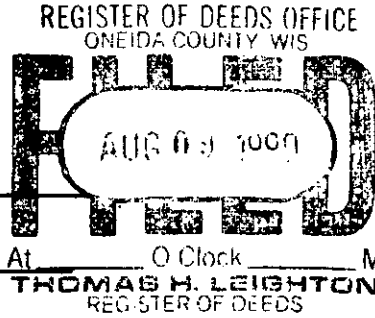

(b) (f) (g) (h) Description of monument found at this corner and if it was accepted, state all evidence (material, testimonial, occupational, plats, records, other monuments) used as a basis for accepting. If not accepted or if nothing was found, state evidence used as basis for establishing location. If reestablished through lost corner proportionate methods, indicate all monuments, distances and directions used to establish. Indicate type of monument found or set and sign post.

Original Survey by Alex Anderson, May 9, 1865 - Monument: Wood Post
 Witnesses: Birch 5" N8730E 195 links - no others

No original or other corner evidence found.

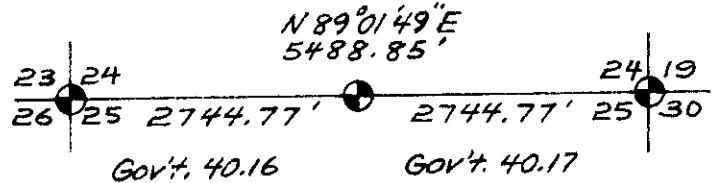


I set this corner with a County Berntsen Mon. and Plastic Post at one half distance on line as shown. This corner sits on a ridge of high ground between swamps not called for in org. notes, but had to have been crossed.

= Berntsen & Post

(c) (d) (e) Plan view of corner with ties to at least 4 witness monuments. If in disagreement with previously established corner, show the distances between the two corners and also indicate the ties to the disputed corner.

Note: measured to the head of 6" nails

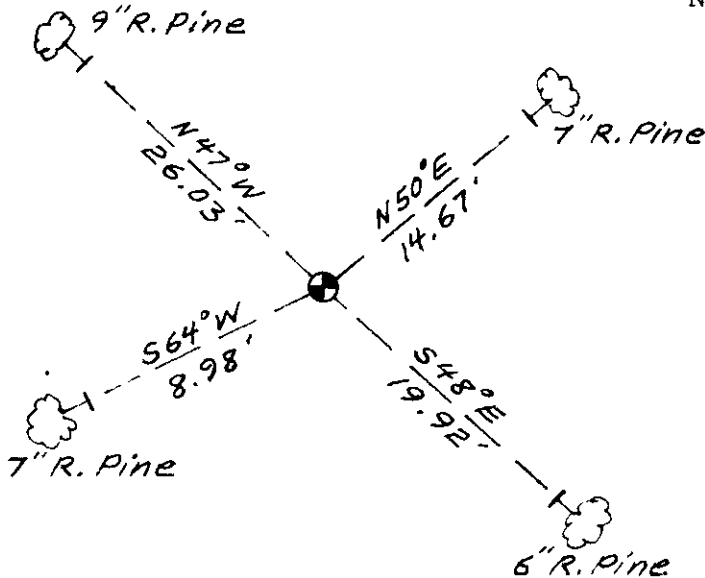

(i) I, William H. Stuth, RLS No. S-1418
 (type or print name) certify that the corner location on this record was determined by me or under my direction and control and that this U.S. Public Land Survey Monument Record is correct and complete to the best of my knowledge and belief.

William H. Stuth June 28, 1990
 Signature Date



Stamp
 3904240020

Index No. R - 23