U.S. PUBLIC LAND SURVEY MONUMENT RECORD

Note: This form is intended and designed to fulfill all requirements of Wisconsin Administrative Code, Chapter A-E 5.02, U.S. Public Land Survey Monument Record (3) (a) (b) (c) (d) (e) (f) (g) (h) (i). An additional sheet may be added if necessary to conform with said requirements.

(a) Corner location: Township 39 North

Range 4 East/West

Town/City/Village Minocqua

County Oneida

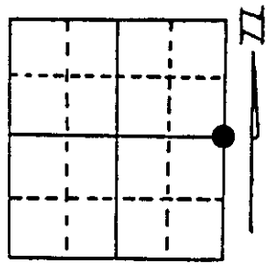

Section 27

(b) (f) (g) (h) Description of monument found at this corner and if it was accepted, state all evidence (material, testimonial, occupational, plats, records, other monuments) used as a basis for accepting. If not accepted or if nothing was found, state evidence used as basis for establishing location. If reestablished through lost corner proportionate methods, indicate all monuments, distances and directions used to establish.

The original Government survey was performed by Alexander Anderson in 1865.

Set wood corner post East One Quarter Corner

Re-established by lot corner proprtionate methods

REGISTER OF DEEDS OFFICE
ONEIDA COUNTY, WIS.
FILED
At 8:00 O'Clock A M
DORIS VERAGE KUEHN
REGISTER OF DEEDS

(c) (d) (e) Plan view of corner with ties to at least 4 witness monuments. If in disagreement with previously established corner, show the distances between the two corners and also indicate the ties to the disputed corner. Set Oneida County 2" diameter aluminum pipe 30" long with 3" diameter tablet, stamped to identify corner. Set nails in P.T.'s.

White Pine 12" S21°W 26.60 feet

White Pine 12" N75°W 88.60 feet

Poplar 5" N41°E 33.90 feet

Balsam 11" S74°E 49.50 feet

Plastic Sign Post N45°W 1 foot

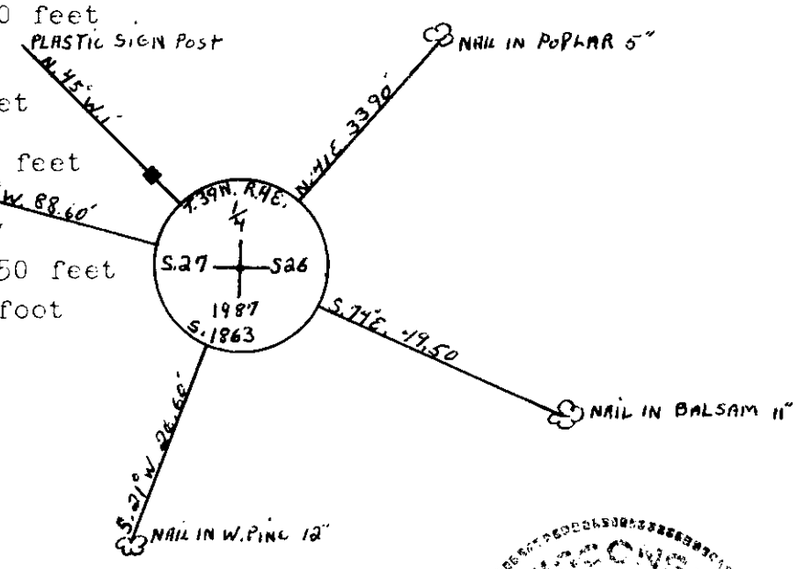

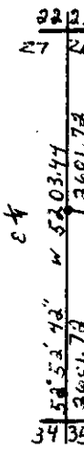

(i) I, Dennis D. Roberts (type or print name) certify that the corner location on this record was determined by me or under my direction and control and that this U.S. Public Land Survey Monument Record is correct and complete to the best of my knowledge and belief.

Dennis D. Roberts — May 20, 1987

Signature — Date

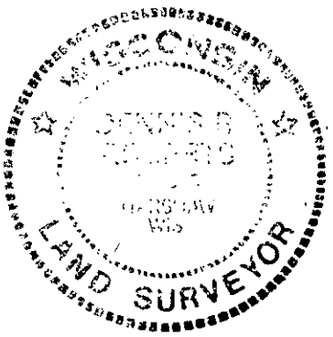

Index No. T-39-N R-4-E S-27

3904282000