U.S. PUBLIC LAND SURVEY MONUMENT RECORD

Note: This form is intended and designed to fulfill all requirements of Wisconsin Administrative Code, Chapter A-E 7.08 U.S. Public Land Survey Monument Record (3)(a-i).

(a) CORNER LOCATION
Meander Cor. of Secs. 31 & 36
Township 39 North
Range 4 & 5 East of the 4th P.M.
Town of Minocqua
County of Oneida

WISCRS - Oneida County
N: 231,569.96 USft
E: 133,936.32 USft
Datum: NAD 83(2011)
GNSS Method: Static Offset
GNSS Control: WISCORS VRS

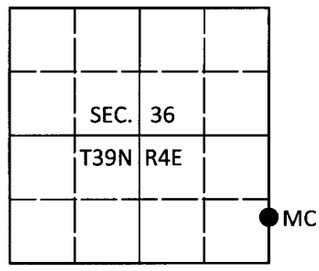

(b) HISTORY OF ORIGINAL CORNER ESTABLISHMENT

Original Surveyor: Alfred Millard

Original Accessories:
Y. Pine 18 S32°W, 8 lks.
W. Pine 12 S39°E, 18 lks.

Date of Survey Commenced: Sep., 1860
Completed: Sep., 1860

(b)(f)(g)(h) Description of monument found at this corner and if it was accepted, state all evidence (material, testimonial, occupational, plats, records, other monuments) used as a basis for accepting. If not accepted or if nothing was found, state evidence used as basis for establishing location. If re-established through lost corner proportionate methods, indicate all monuments, distances and directions used to establish. Indicate type of monument and sign post found or set.

March 25, 1940: Notes by Hall in CCC book 11 on page 59 indicate corner is marked by an iron pipe with the following bearing trees: 2" cedar NW 6.45'; 1.5" cedar NE, 1.00'.

October 10, 1996: OCS Map No. B-3512 by James D. Rein, RLS indicates corner is marked by a brass capped iron pipe.

May 19, 2017: Jeff Austin visited the corner and recovered the record monument, a 2" diam. iron pipe with a 2-1/2" diam. brass cap projecting 12" above the ground surface. Hall's NW cedar is down; the other cedar is gone. A 3" diam. iron "survey" disk is 0.3 ft. North of the corner. Accessories were found or established as shown below. A white vinyl sign post was found Southwest, 0.8 ft.

The coordinate value shown has been verified by at least one of the following methods: 1) comparison to a previously GPS determined published value; 2) the value is the average of two or more GPS observations at a markedly different time; 3) one or more distances were measured back to the GPS observed corner from temporary GPS observed offset locations.

(c)(d)(e) Plan view of corner with ties to at least 4 witness monuments. If in disagreement with previously established corner, show the distances between the two corners and also indicate the ties to the disputed.

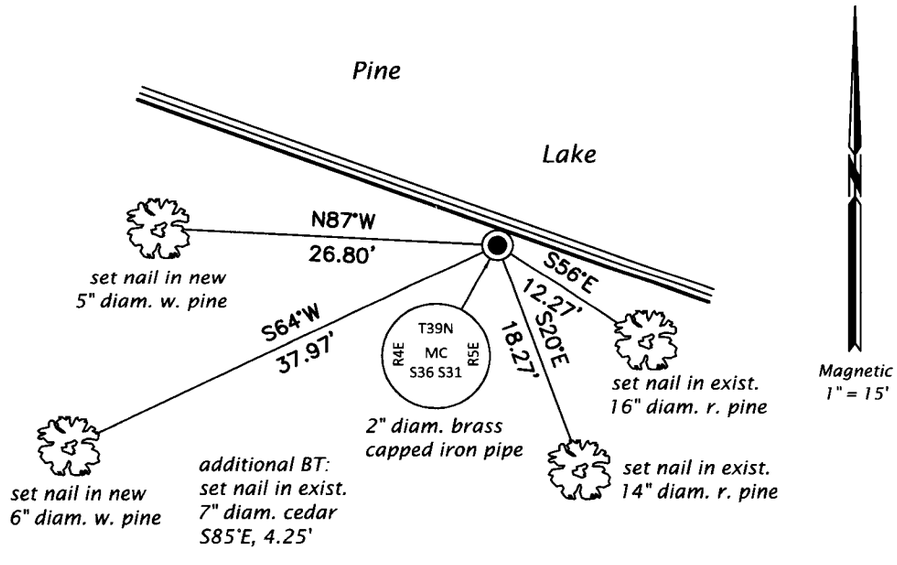

ONEIDA COUNTY
FILED
JUL 11 2017
AT ____ O'CLOCK ____ M
KYLE J. FRANSON
REGISTER OF DEEDS

(i) I, Michael J. Romportl, Professional Land Surveyor No. S-1624, hereby certify that the corner location on this record was determined by me or under my direction and control and that this U.S. Public Land Survey Monument Record is correct and complete to the best of my knowledge and belief.

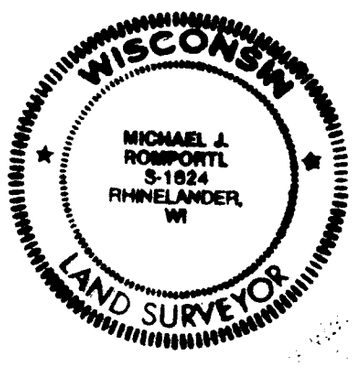

Michael J Romportl
Signature

7/11/2017
Date

3904360700 (INDEX NO. Y,Z-25)