U.S. PUBLIC LAND SURVEY MONUMENT RECORD

Note: This form is intended and designed to fulfill all requirements of Wisconsin Administrative Code, Chapter A-E 7.08 U.S. Public Land Survey Monument Record (3) (a) (b) (c) (d) (e) (f) (g) (h) (i). An additional sheet may be added if necessary to conform with said requirements.

(a) Corner location: Township 39 North

Range 5 East/~~West~~

Town/~~City~~/~~Village~~ MINOCQUA

County ONEIDA

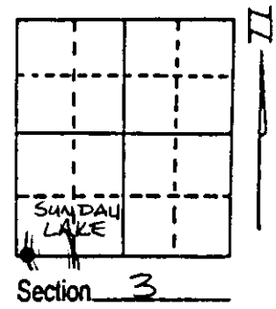

Section 3

(b) (f) (g) (h) Description of monument found at this corner and if it was accepted, state all evidence (material, testimonial, occupational, plats, records, other monuments) used as a basis for accepting. If not accepted or if nothing was found, state evidence used as basis for establishing location. If reestablished through lost corner proportionate methods, indicate all monuments, distances and directions used to establish. Indicate type of monument found or set and sign post.

Sept. 17th, 1863 - Alexander Anderson, Deputy Surveyor, set Meander Corner witnessed by two bearing trees: a 8" Y. Pine bearing S27°W, 49 links; and a 20" Y. Pine bearing N46°W, 46 links.

Feb. 19th, 1991 - James D. Rein, Reg. Land Surveyor, recovered a 3/4" iron pipe and found no evidence of original bearing trees. The corner to Sections 3-4-9-10 bears S89°14'52"W (Grid North bearing) for a distance of 280. 43 feet (Record is 300.96 feet). Because the existing monument position is harmonious with the record, I accept it as the best evidence for the original corner and replaced the 3/4" iron pipe with a capped 2" dia. x 30" long aluminum monument. Made reference ties as shown in plan view and set a plastic post 1 foot Northwest of corner monument.

(c) (d) (e) Plan view of corner with ties to at least 4 witness monuments. If in disagreement with previously established corner, show the distances between the two corners and also indicate the ties to the disputed corner.

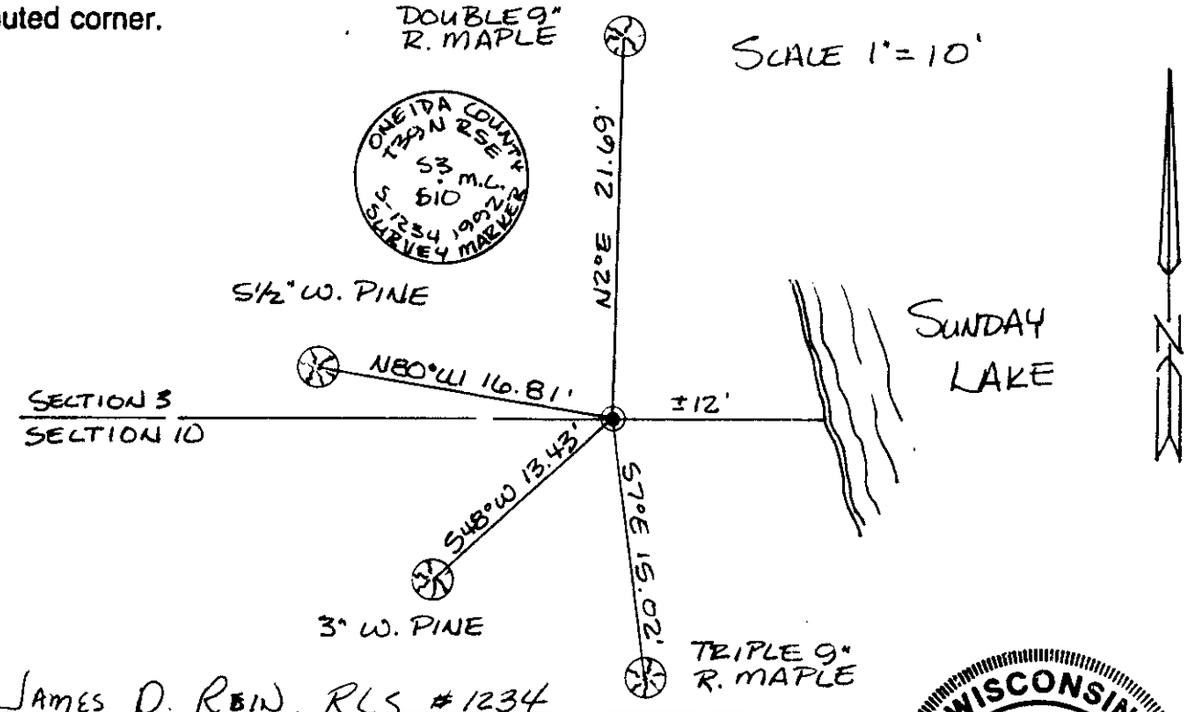

(i) I, JAMES D. REIN, RLS #1234 (type or print name) certify that the corner location on this record was determined by me or under my direction and control and that this U.S. Public Land Survey Monument Record is correct and complete to the best of my knowledge and belief.

Signature

2-21-92
Date

WISCONSIN
JAMES D. REIN
S-1234
MINOCQUA, WI
LAND SURVEYOR

3905030037
Stamp

Index No. E-13,14