


U.S. PUBLIC LAND SURVEY MONUMENT RECORD

Note: This form is intended and designed to fulfill all requirements of Wisconsin Administrative Code, Chapter A-E 7.08 U.S. Public Land Survey Monument Record (3)(a)(b)(c)(d)(e)(f)(g)(h)(i). An additional sheet may be added if necessary to conform with said requirements.

(a) CORNER LOCATION: State Plane Coordinates
 South 1/16 corner of Sec. 9&10 X _____
 Township 39 North Y _____
 Range 5 East Datum Base _____
 Town/City Minocqua County of Oneida

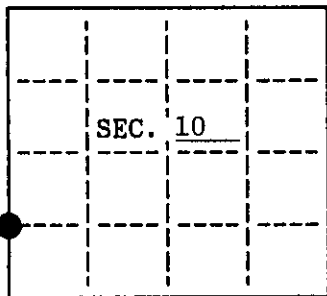

(b) HISTORY OF ORIGINAL CORNER ESTABLISHMENT


Original Surveyor: None
 Date of Survey: Commenced _____
 Completed _____

Original B.T.'S


(b)(f)(g)(h) Description of monument found at this corner and if it was accepted, state all evidence (material, testimonial, occupational, plats, records, other monuments) used as a basis for accepting. If not accepted or if nothing was found, state evidence used as basis for establishing location. If reestablished through lost corner proportionate methods, indicate all monuments, distances and directions used to establish. Indicate type of monument and sign post found or set.

August 10, 1994: I established this corner on the line common to Sections 9 and 10 by single proportionate measure. The One-Quarter Corner bears N2°36'20"W, 1308.19 feet (GLO 20.00 Chs.). The Meander Corner bears S2°36'20"E, 608.31 feet (GLO 9.30 Chs.). I set an Oneida County Aluminum Monument witnessed as shown below. I set a plastic signpost northwest 1.5 feet.

(c)(d)(e) Plan view of corner with ties to at least 4 witness monuments. If in disagreement with previously established corner, show the distances between the two corners and also indicate the ties to the disputed.

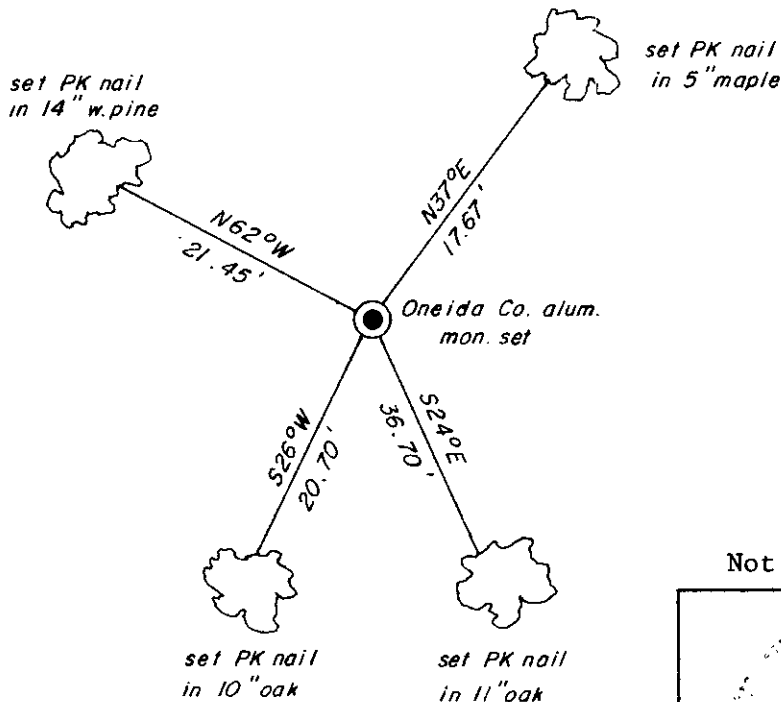

Not to Scale

 

INDEX NO. H-13

(i) I, Stuart L. Foltz, Reg. Land Surveyor #S-1170 hereby certify that the corner location on this record was determined by me or under my direction and control and that this U.S. Public Land Survey Monument Record is correct and complete to the best of my knowledge and belief.

Stuart L. Foltz
 Signature

3/2/1995
 Date

3905091000