

CERTIFIED LAND CORNER RESTORATION

State of Wisconsin }
County of Oneida } ss.

I, James D. Rein, do hereby certify that on the 7th day of April, 19 81, I found evidence of the West one-quarter corner of Section 12 Township 39 North, Range 5 East, Fourth Principal Meridian, as described hereon; and that from this evidence I established a new monument and accessories as described hereon to perpetuate the original location of this corner:

Description of original monument and accessories and subsequent restorations:

Sept. 15th, 1863- Alex. Anderson, Deputy Surveyor, set wood post witnessed by a White Pine 12" S57°W, 16 lks (10.56 ft.) and by a White Pine 12" N27½°E, 39 lks (25.74 ft.)
Aug., 1944 - E. F. Kowalke-Set Oak post in old road and assume telephone pole as N-S Section line and S22½°W, 39 lks (25.74 ft.) from rotted stump, New BTs, 24" Yellow Pine N58°W, 26.7 feet and 16" White Pine N24°E, 35.6 feet.


March, 1964- James G. Griffin, RLS, map legends corner being monumented by iron pipe witnessed by a 25" Norway Pine N60°W, 26.6 feet.

Description of corner evidence found:



2" diameter Iron Pipe flush in overgrown East-West roadbed, witnessed by a 26" Norway Pine N60°W, 26.7 feet and by an 18" White Pine (dead) N25°E, 35.2 feet.

Description of monument and accessories I established to perpetuate the location of this corner:

Set P.K. nail in existing bearing tree 26" Norway Pine (Scr. "S¼ 26") N60°W, 26.68 feet.
Made bearing trees (Scr 1/4 S B.T.) with P.K. nail set in lower blaze as follows:
8" Norway Pine S82°W, 43.17 feet
7" White Pine S48°E, 13.28 feet

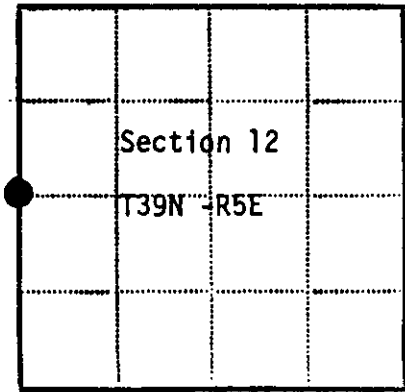

● - Corner monument restored
□ -

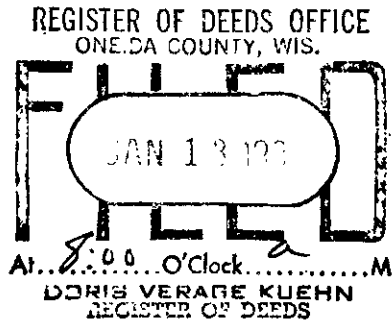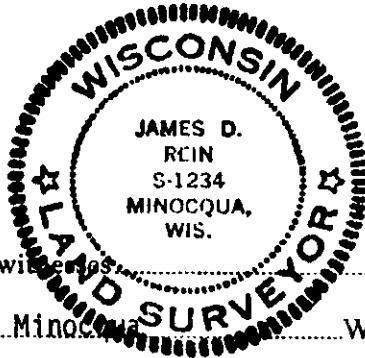

Resident witness

Dated at Minocqua, Wisconsin, this 11th day of May 19 81.

Signature [Handwritten Signature] Title Reg. Land Surveyor
(County Surveyor, Registered Land Surveyor, or other duly authorized official)

Surveyors Registration No. S-1234

Office of _____ County of _____

I hereby certify that the within instrument was filed in this office for record on the _____ day of _____ 19 _____, and was filed in Book No. _____ Page No. _____ of County Records.

Signature _____ Title _____

Township _____, Range _____, Section _____, Index No. _____, Page No. _____