

U.S. PUBLIC LAND SURVEY MONUMENT RECORD


Note: This form is intended and designed to fulfill all requirements of Wisconsin Administrative Code, Chapter A-E 7.08 U.S. Public Land Survey Monument Record (3)(a)(b)(c)(d)(e)(f)(g)(h)(i). An additional sheet may be added if necessary to conform with said requirements.

(a) Corner location: Township 39 North

Range 5 East

Town of Minocqua

Oneida County, Wisconsin

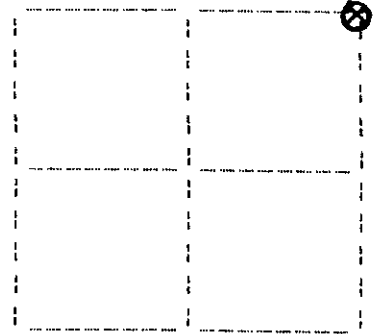

Section 28

(b)(f)(g)(h) Description of monument found at this corner and if it was accepted, state all evidence (material, testimonial, occupational, plats, records, other monuments) used as a basis for accepting. If not accepted or if nothing was found, state evidence used as basis for establishing location. If reestablished through lost corner proportionate methods, indicate all monuments, distances and directions used to establish. Indicate type of monument found or set and sign post.

September, 1863: Alexander Anderson notes the following: 80.00 set post cor. to secs. 21,22,27&28: tamarac 7 N43°W, 20 lks.; do 7 N51°E, 25 lks.


October 18, 1934: Hall page 212 notes the following: 912 steps fall 22 steps W of orig. NEx found by Koszewski. set new stake at record distance from stps. of both orig. marks ok. orig. N43°W, 13-2/10 ft.; orig. N49°E, 16-5/10 ft.; orig. (not noted) S39°E, 20-1/10 ft. new: cedar 11° S67°E, 30'; cedar 9° S10°W, 14'.

August 19, 1990: I found and accepted a 3" dia. wood post. I replaced said post with a 2-1/2" dia. aluminum cap on a 72" long aluminum post stamped as shown below. I found the following witnesses: rotted stump S36°E, 20.4 feet; set nail in spruce 6" N55°E, 18.00 feet; set nail in cedar 18" S62°E, 30.82 feet; set nail in cedar 14" S13°W, 14.97 feet; set nail in spruce 9" S62°W, 11.57 feet; set plastic sign post north, 1 foot.

(c)(d)(e) Plan view of corner with ties to at least four witness monuments. If in disagreement with previously established corner, show the distances between the two corners and also indicate the ties to the disputed corner.

1. nail in spruce 6" N55E, 18.00 feet.
2. nail in cedar 18" S62E, 30.82 feet.
3. nail in cedar 14" S13W, 14.97 feet.
4. nail in spruce 9" S82W, 11.57 feet.

(not to scale)

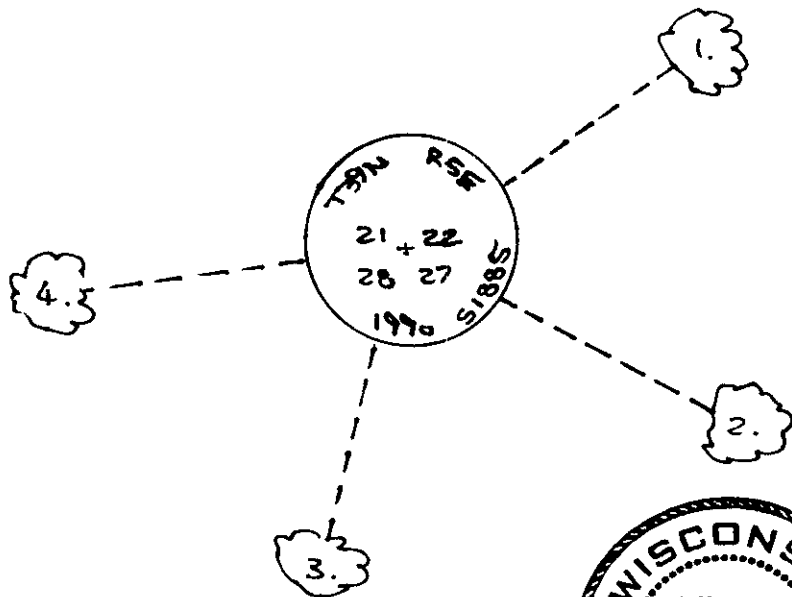

I, Jeffrey W. Austin, Registered Land Surveyor S-1885 certify that the corner location on this record was determined by me or under my direction and control and that this U.S. Public Land Survey Monument Record is correct and complete to the best of my knowledge and belief.

Jeffrey W. Austin
 Signature _____ Date SEPTEMBER 3, 1990



Index no. R-13

3905210000

R-13