

U. S. PUBLIC LAND SURVEY MONUMENT RECORD


Note: This form is intended and designed to fulfill all requirements of Wisconsin Administrative Code, Chapter ATC 7.08 U.S. Public Land Survey Monument Record, and for recording in the Public Land Survey Monument Record. An additional sheet may be added if necessary to conform with said requirements.

(a) Corner location: Township 39 North

Range 5 East

Town of Minocqua

Oneida County, Wisconsin

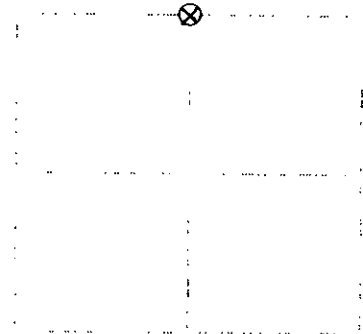

Section 27

(b) (i) (h). Description of monument found at this corner and if it was accepted, state all evidence (material, testimonial, occupational, plats, records, other monuments) used as a basis for accepting. If not accepted or if nothing was found, state evidence used as basis for establishing location. If reestablished through lost corner proportionate methods, indicate all monuments, distances and directions used to establish. Indicate type of monument found or set and sign post.

September, 1867: Alexander Anderson, US deputy surveyor notes the following: 39.95 set 1/4 sec post: aspen 10 S41W, 17 lbs.; aspen 6 N41E, 8 lbs.


October 14, 1910: DOD book 12, page 10 notes the following: 39.967 rd. angle N 110 W, & drive iron bolt & mark: 1/4 pine 6" N82W, 1.45 ft. set cedar post.

November 8, 1990: I found and accepted a 3/4" dia., 30" long iron rod with old wood post. I replaced rod with aluminum post, 30" long, 1-1/2" dia., 25" in the ground with aluminum cap marked as shown below. I buried a deep 1" magnet at the base of post. I found the following witnesses: scribed pine stump N82W, 19.9 feet. I established the following witnesses: set nail in oak 4" N49E, 3.08 feet; set nail in w.pine 10" S8E, 49.40 feet; set nail in w.pine 12" S51W, 39.83 feet; set nail in w.pine 16" N70W, 38.94 feet; set glassed sign post horizon, 1 foot.

(c) (i) (e) Plan view of corner with ties to at least four witness monuments. If in disagreement with previously established corner, show the distances between the two corners and also indicate the ties to the disputed corner.

1. nail in oak 4"
N49E, 3.08 feet.
2. nail in w.pine 10"
S8E, 49.40 feet.
3. nail in w.pine 12"
S51W, 39.83 feet.
4. nail in w.pine 16"
N70W, 38.94 feet.

(not to scale)

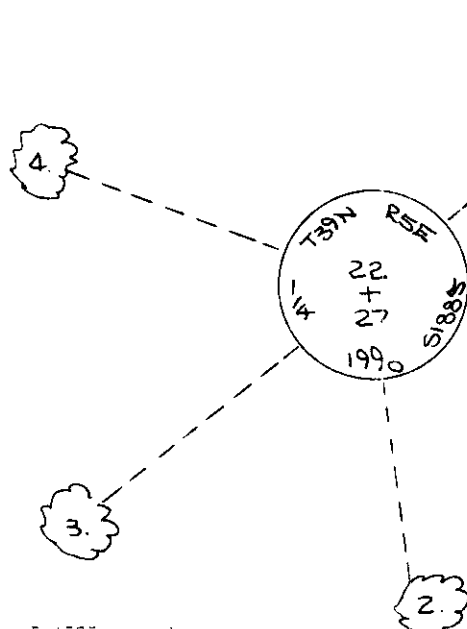

**REGISTER OF DEEDS OFFICE
ONEIDA COUNTY, WIS.**

FILED

DEC 12 1990

At _____ O'Clock _____ M
THOMAS H. LEIGHTON
REGISTER OF DEEDS



I, Jeffrey W. Austin, Registered Land Surveyor S-1885 certify that the corner location on this record was determined by me or under my direction and control and that this U.S. Public Land Survey Monument Record is correct and complete to the best of my knowledge and belief.

Jeffrey W. Austin
November 30, 1990

Index no. R-15

3905220020