


U. S. PUBLIC LAND SURVEY MONUMENT RECORD

Note: This form is intended and designed to fulfill all requirements of Wisconsin Administrative Code, Chapter A-E 7.08 U.S. Public Land Survey Monument Record(3)(a)(b)(c)(d)(e)(f)(g)(h)(i). An additional sheet may be added if necessary to conform with said requirements.

(a) Corner location: Township 39 North
 Range 5 East
 Town of Minocqua
 Oneida County, Wisconsin

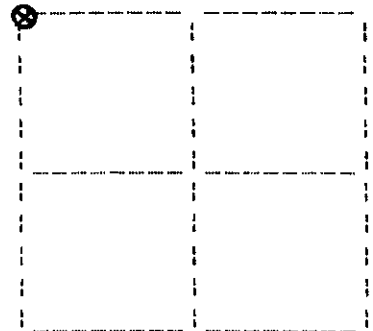

Section 25

(b)(f)(g)(h) Description of monument found at this corner and if it was accepted, state all evidence (material, testimonial, occupational, plats, records, other monuments) used as a basis for accepting. If not accepted or if nothing was found, state evidence used as basis for establishing location. If reestablished through lost corner proportionate methods, indicate all monuments, distances and directions used to establish. Indicate type of monument found or set and sign post.




September, 1863: Alexander Anderson, US deputy surveyor notes the following: 80.00 set past cor. to secs. 23,24,25&26: y.pine 12 N28E, 10 links; y.pine 10 S42W, 19 links.

May 12, 1931: Hall page 224 notes the following: 80.336 orig. cor. identified by both stumps. record from both falls just NE of post found. orig. cor. is just about 1 lk. SW of fence cor. (fence runs E&S) 5-21-31 set 5" sq. concrete monument 6" exposed. y.pine 15" N60E, .965.

September 12, 1990: I found and accepted a 5" sq. 42" long concrete monument. I replaced said monument with a 2-1/2" dia. aluminum post, 24" in the ground, with a 3-1/4" dia. aluminum cap marked as shown below. I found the following witnesses: pine stump(hall) N63E, 64.2 feet; w.pine(dead) 15" S82W, 22.8 feet; set nail in j.pine 14" N20E, 23.50 feet; old fence line runs south. I established the following witnesses: set nail in n.pine 7" S45E, 27.57 feet; set nail in maple 8" S25W, 17.18 feet; set nail in j.pine 7" N31W, 5.85 feet; set plastic sign post north, 1 foot.

(c)(d)(e) Plan view of corner with ties to at least four witness monuments. If in disagreement with previously established corner, show the distances between the two corners and also indicate the ties to the disputed corner.

1. nail in j.pine 14" N20E, 23.50 feet
 2. nail in n.pine 7" S45E, 27.57 feet
 3. nail in maple 8" S25W, 17.18 feet
 4. nail in j.pine 7" N31W, 5.85 feet
- (not to scale)

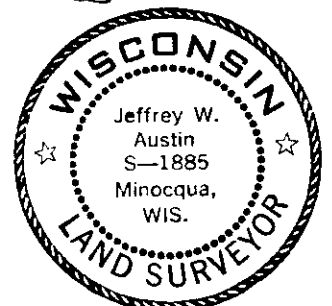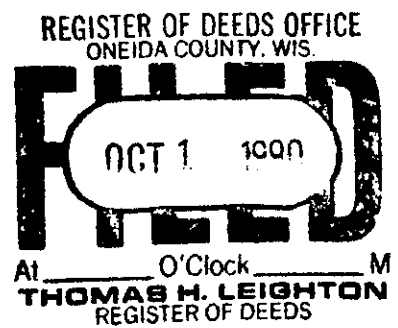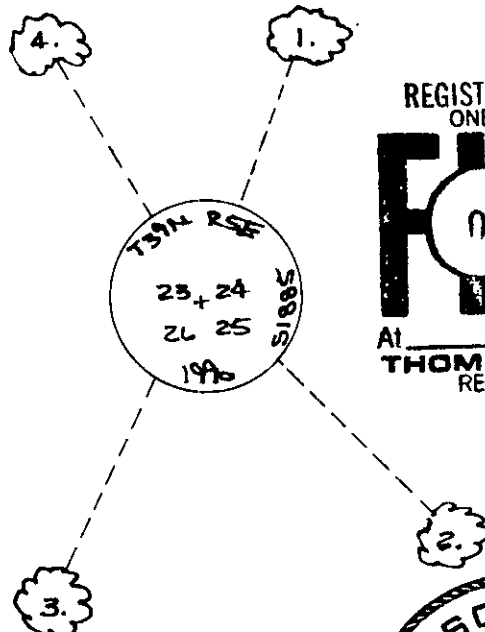

I, Jeffrey W. Austin, Registered Land Surveyor S-1885 certify that the corner location on this record was determined by me or under my direction and control and that this U.S. Public Land Survey Monument Record is correct and complete to the best of my knowledge and belief.

Signature: *Jeffrey W. Austin* Date: SEPTEMBER 30, 1990

Index no. R-21

3905230000