


U.S. PUBLIC LAND SURVEY MONUMENT RECORD

Note: This form is intended and designed to fulfill all requirements of Wisconsin Administrative Code, Chapter A-E 7.09 U.S. Public Land Survey Monument Record (31x44x11) (date: 4/3/77). An additional sheet may be added if necessary to conform with said requirements.

(a) Corner location: Township 39 North
 Range 5 East
 Town of Minocqua
 Oneida County, Wisconsin

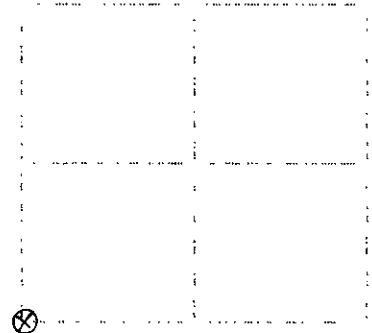

Section 25

(b) (1) (g) (ii) Description of monument found at this corner and if it was accepted, state all evidence (material, testimonial, occupational, plats, records, other monuments) used as a basis for accepting. If not accepted or if nothing was found, state evidence used as basis for establishing location. If reestablished through lost corner proportionate methods, indicate all monuments, distances and directions used to establish. Indicate type of monument found or set and sign post.

September, 1860: Alexander Anderson, US deputy surveyor notes the following: 90.00' set post cor to secs 25, 26, 35 & 36; aspen & N36E, 75 lks.; oak oak S 85SE, 26 lks.


Mar 13, 1931: Hal: page 225 notes the following: 80.211 identified SW cor by old stake hole agreeing with oak stp. & aspen remains. There is small recent stake about .01' from spot. Drive temp. nup and mark: y.pine 10" N8-1/2E, 1.400; y.pine 6" S4-1/2E, .371; drive pitch hubs in old brng. locations i.e. oak S56-1/2E, .25; poplar N35-3/4E, .75. set mon. 3-20-31.

October 3, 1990: I found and accepted a 3" sq., 40" long concrete monument at the corner of fences running south and east. I replaced said monument with an aluminum post 30" long, 2-1/2" dia. with aluminum cap 6" above the ground marked as shown below. I found the following witnesses: old wood post in rotten stump (all Anderson) N35E, 49.5 feet; set nail in n.pine (nail: N8° 19E, 93.00 feet; set nail in n.pine (nail: S4E, 38.20 feet. I established the following witnesses: set nail in w.pine 6" S56W, 28.20 feet; set nail in w.pine 5" N55W, 21.77 feet; set plastic sign post north, 1 foot; buried deep 1" magnet below ground.

(c) (1) (a) Plan view of corner with ties to at least four witness monuments. If in disagreement with previously established corner, show the distances between the two corners and also indicate the ties to the disputed corner.

1. nail in n.pine 18" N9E, 93.00 feet.
2. nail in n.pine 16" S4E, 38.20 feet.
3. nail in w.pine 6" S56W, 28.20 feet.
4. nail in w.pine 5" N55W, 21.77 feet.

(not to scale)

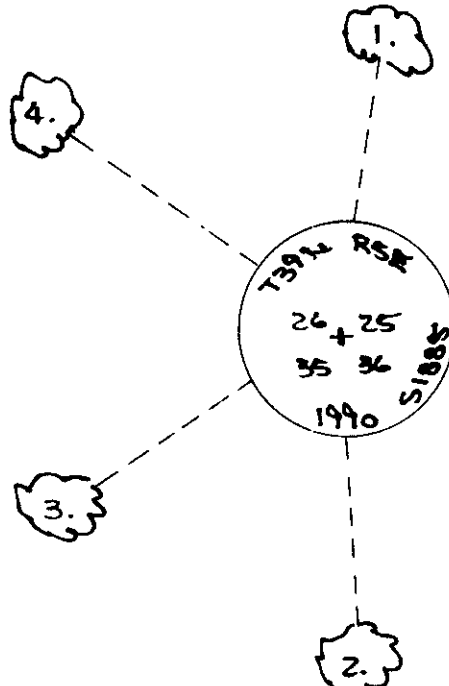

REGISTER OF DEEDS OFFICE
 ONEIDA COUNTY WIS

FILED
 NOV 7 1990

At _____ O'Clock _____ M
THOMAS H. LEIGHTON
 REGISTER OF DEEDS

I, Jeffrey W. Austin, Registered Land Surveyor 6-1585 certify that the corner location on this record was determined by me or under my direction and control and that this U.S. Public Land Survey Monument Record is correct and complete to the best of my knowledge and belief.

Jeffrey W. Austin October 30, 1990



Index no. V-21

3905260000