

**U.S. PUBLIC LAND SURVEY MONUMENT RECORD**


Note: This form is intended and designed to fulfill all requirements of Wisconsin Administrative Code, Chapter A-E 7.08 U.S. Public Land Survey Monument Record(3)(a)(b)(c)(d)(e)(f)(g)(h)(i). An additional sheet may be added if necessary to conform with said requirements.

(a) Corner location: Township 39 North

Range 5 East

Town of Minocqua

Oneida County, Wisconsin

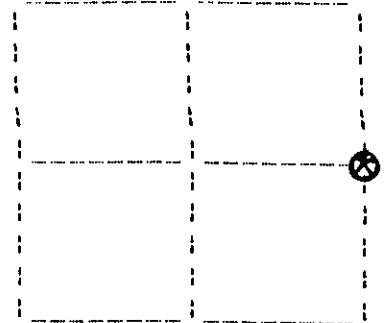

Section 29

(b)(f)(g)(h) Description of monument found at this corner and if it was accepted, state all evidence (material, testimonial, occupational, plats, records, other monuments) used as a basis for accepting. If not accepted or if nothing was found, state evidence used as basis for establishing location. If reestablished through lost corner proportionate methods, indicate all monuments, distances and directions used to establish. Indicate type of monument found or set and sign post.

September, 1863: Alexander Anderson notes the following: 40.0; set 1/4 sec. post: y.pine 15 N57°E, 147 lks.; do 10 N20°W, 132 lks.


May 16, 1934: Hall page 211 notes the following: 1 pace from old road junction in NESE 29 N31-1/2°E, 82 steps; thence north, 171 steps. fall about 10 feet S of old post (down) agreeing with orig. NE brng. (down) no sign of recent attention nor of other bearing. comes at E edge of swamp. old rd. brs. E 176 steps. May 28, 34 set wis. conserv. monument & tamarac post. new bearings: (?)

August 25, 1990: I found and accepted a 3" dia. WCD brass cap on an iron post at east edge of bog stamped as shown below. I found no record witnesses. I established the following witnesses: set nail in spruce 5" N11E, 12.79 feet; set nail in w.pine 6" N72W, 15.33 feet; set nail in w.pine 12" S69W, 19.54 feet; set nail in w.pine 12" S21W, 27.25 feet; set plastic sign post north, 1 foot.

(c)(d)(e) Plan view of corner with ties to at least four witness monuments. If in disagreement with previously established corner, show the distances between the two corners and also indicate the ties to the disputed corner.

1. nail in spruce 5" N11E, 12.79 feet.
2. nail in w.pine 6" N72W, 15.33 feet.
3. nail in w.pine 12" S69W, 19.54 feet.
4. nail in w.pine 12" S21W, 27.25 feet.

(not to scale)

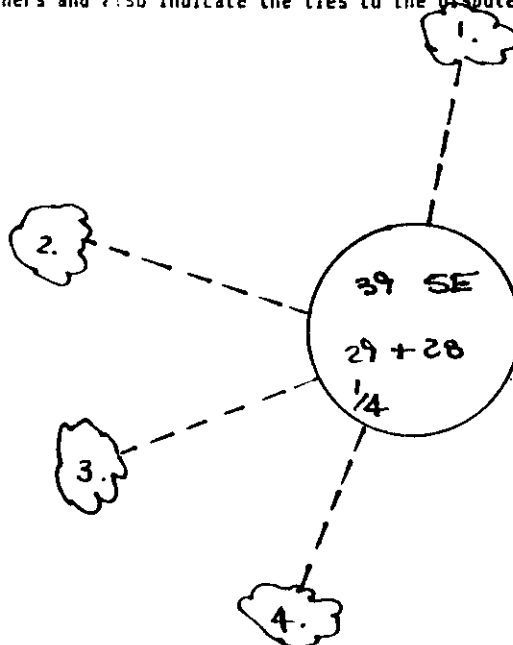

REGISTER OF DEEDS OFFICE  
ONEIDA COUNTY, WIS.  
**FILED**  
SEP 11 1991  
At \_\_\_\_\_ O'Clock \_\_\_\_\_ M  
**THOMAS H. LEIGHTON**  
REGISTER OF DEEDS

WISCONSIN  
Jeffrey W. Austin  
S-1885  
Minocqua,  
WIS.  
LAND SURVEYOR

I, Jeffrey W. Austin, Registered Land Surveyor S-1885 certify that the corner location on this record was determined by me or under my direction and control and that this U.S. Public Land Survey Monument Record is correct and complete to the best of my knowledge and belief.

*Jeffrey W. Austin*  
Signature

September 3, 1990  
Date

Index no. T-9

3905292000

T-9