U.S. PUBLIC LAND SURVEY MONUMENT RECORD

Note: This form is intended and designed to fulfill all requirements of Wisconsin Administrative Code, Chapter A-E 7.08 U.S. Public Land Survey Monument Record (3)(a-i).

(a) CORNER LOCATION
1/4 Cor. of Secs. 5 & 32
Township 38 & 39 North
Range 5 East of the 4th P.M.
Town of Minocqua
County of Oneida

WISCRS - Oneida County
N: 230,535.98 USft
E: 141,880.63 USft
Datum: NAD 83(2011)
GNSS Method: Real-Time Network
GNSS Control: WISCORS VRS

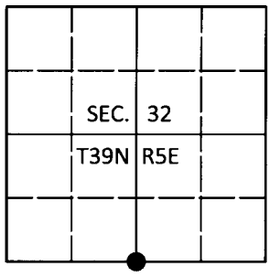

(b) HISTORY OF ORIGINAL CORNER ESTABLISHMENT

Original Surveyor: Alfred Millard

Date of Survey Commenced: Sep., 1860
Completed: Sep., 1860

Original Accessories:
Pine 12 N35°W, 57 lks.
Pine 12 S5°E, 20 lks.

(b)(f)(g)(h) Description of monument found at this corner and if it was accepted, state all evidence (material, testimonial, occupational, plats, records, other monuments) used as a basis for accepting. If not accepted or if nothing was found, state evidence used as basis for establishing location. If re-established through lost corner proportionate methods, indicate all monuments, distances and directions used to establish. Indicate type of monument and sign post found or set.

April 13, 1935: Notes by Hall in CCC book 4 on page 66 indicate he searched for the corner and found nothing noting many stumps entirely burned.

June 20, 2017: Jeff Austin thoroughly searched this corner finding it to be lost with no evidence of the GLO survey in existence. As detailed below, a 1" diam., 30" long iron pipe with a 2" diam. aluminum cap 4" beneath the ground surface was set at the proportionate distance between controlling corners. The distance West to low land is 125 ft. comparing well to the GLO distance of 2.50 chains. A 1" diam. iron pipe of unknown origin bears S88°W, 61.29 ft. Accessories were established as shown below. A white vinyl sign post was set adjacent to the 1" diam. iron pipe found.

The coordinate value shown has been verified by at least one of the following methods: 1) comparison to a previously GPS determined published value; 2) the value is the average of two or more GPS observations at a markedly different time; 3) one or more distances were measured back to the GPS observed corner from temporary GPS observed offset locations.

(c)(d)(e) Plan view of corner with ties to at least 4 witness monuments. If in disagreement with previously established corner, show the distances between the two corners and also indicate the ties to the disputed.

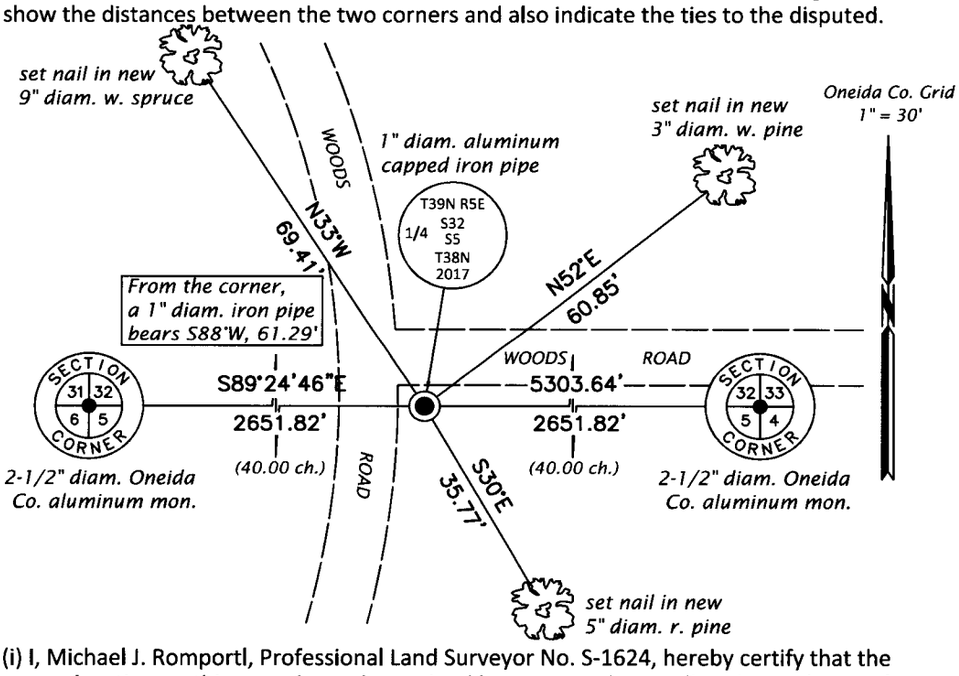

ONEIDA COUNTY
FILED
JUL 11 2017
AT ____ O'CLOCK ____ M
KYLE J. FRANSON
REGISTER OF DEEDS

(i) I, Michael J. Romportl, Professional Land Surveyor No. S-1624, hereby certify that the corner location on this record was determined by me or under my direction and control and that this U.S. Public Land Survey Monument Record is correct and complete to the best of my knowledge and belief.

WISCONSIN
MICHAEL J. ROMPORTL
S-1624
RHINELANDER
WI
LAND SURVEYOR

Michael J Romportl 7/11/2017
Signature Date

3905320020 (INDEX NO. Z-7)