


U.S. PUBLIC LAND SURVEY MONUMENT RECORD

Note: This form is intended and designed to fulfill all requirements of Wisconsin Administrative Code, Chapter A-E 7.08 U.S. Public Land Survey Monument Record(3)(a)(b)(c)(d)(e)(f)(g)(h)(i). An additional sheet may be added if necessary to conform with said requirements.

(a) Corner location: Township 38 North
 Range 5 East
 Town of Minocqua
 Oneida County, Wisconsin

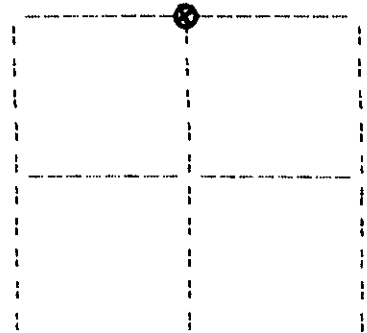

Section 3

(b)(f)(g)(h) Description of monument found at this corner and if it was accepted, state all evidence (material, testimonial, occupational, plats, records, other monuments) used as a basis for accepting. If not accepted or if nothing was found, state evidence used as basis for establishing location. If reestablished through lost corner proportionate methods, indicate all monuments, distances and directions used to establish. Indicate type of monument found or set and sign post.



September, 1860: Alfred Millard, US deputy surveyor notes the following: 40.00 set quarter section post: hemlock 11 N68E, 6; hemlock 10 S30W, 28 links.

August 10, 1933: Hall page 149 notes the following: 40.138 fall 6" N of orig. 1/4 S cor. drive 5' pine post in old hole agreeing with remains of the 2 hemlocks. notch in root of 24" w.pine stp. N3-1/4E, 1.481; pople 4" S38-50W, .715.

September 24, 1990: I found and accepted a 2-1/2" dia. iron post, 8" above ground with 3" dia. cap marked as shown below. This corner is located within a clearcut area and seems to have been protected and preserved by the paper company for many years - I believe this is a perpetuation of the millard/hall location. I found the following witnesses: set nail in j.pine 10" S71E, 4.07 feet; set nail in maple 7" north, 12.01 feet; set nail in j.pine 6" N31W, 4.45 feet. I established the following witnesses: set nail in maple 4" S24W, 9.38 feet; set plastic sign post north, 1 foot.

(c)(d)(e) Plan view of corner with ties to at least four witness monuments. If in disagreement with previously established corner, show the distances between the two corners and also indicate the ties to the disputed corner.

1. nail in j.pine 10" S71E, 4.07 feet
 2. nail in maple 7" north, 12.01 feet
 3. nail in j.pine 6" N31W, 4.45 feet
 4. nail in maple 4" S24W, 9.38 feet
- (not to scale)

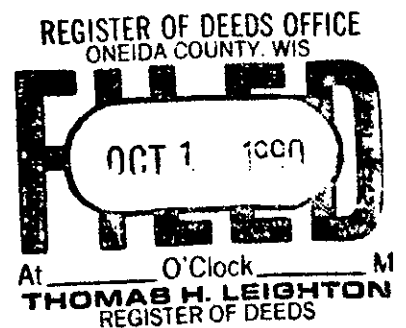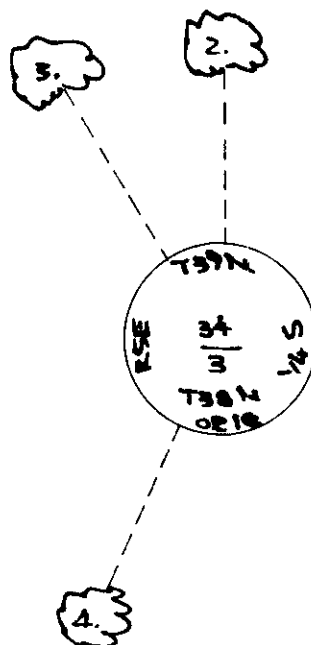

I, Jeffrey W. Austin, Registered Land Surveyor S-1885 certify that the corner location on this record was determined by me or under my direction and control and that this U.S. Public Land Survey Monument Record is correct and complete to the best of my knowledge and belief.

Signature: *Jeffrey W. Austin* Date: September 30, 1990

Index no. A-15

3905340020