U.S. PUBLIC LAND SURVEY MONUMENT RECORD

Note: This form is intended and designed to fulfill all requirements of Wisconsin Administrative Code, Chapter A-E 5.02, U.S. Public Land Survey Monument Record (3) (a) (b) (c) (d) (e) (f) (g) (h) (i). An additional sheet may be added if necessary to conform with said requirements.

(a) Corner location: Township 39 North

Range 6 East/~~West~~

Town/~~City/Village~~ Woodruff

County Oneida

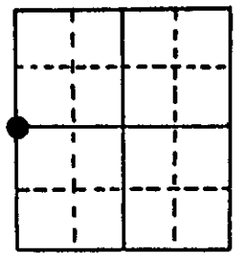

Section 4

(b) (f) (g) (h) Description of monument found at this corner and if it was accepted, state all evidence (material, testimonial, occupational, plats, records, other monuments) used as a basis for accepting. If not accepted or if nothing was found, state evidence used as basis for establishing location. If reestablished through lost corner proportionate methods, indicate all monuments, distances and directions used to establish.

Found and accepted Indian Reservation Boundary Monument. (Brass Tablet in Round Concrete Post).

Original Survey: The original Government Survey was performed by Alexander Anderson in October, 1863.

Wood Post Set:

Black Pine	5"	S41°E	24 lks
Black Pine	6"	S60°W	18 lks.

(c) (d) (e) Plan view of corner with ties to at least 4 witness monuments. If in disagreement with previously established corner, show the distances between the two corners and also indicate the ties to the disputed corner.

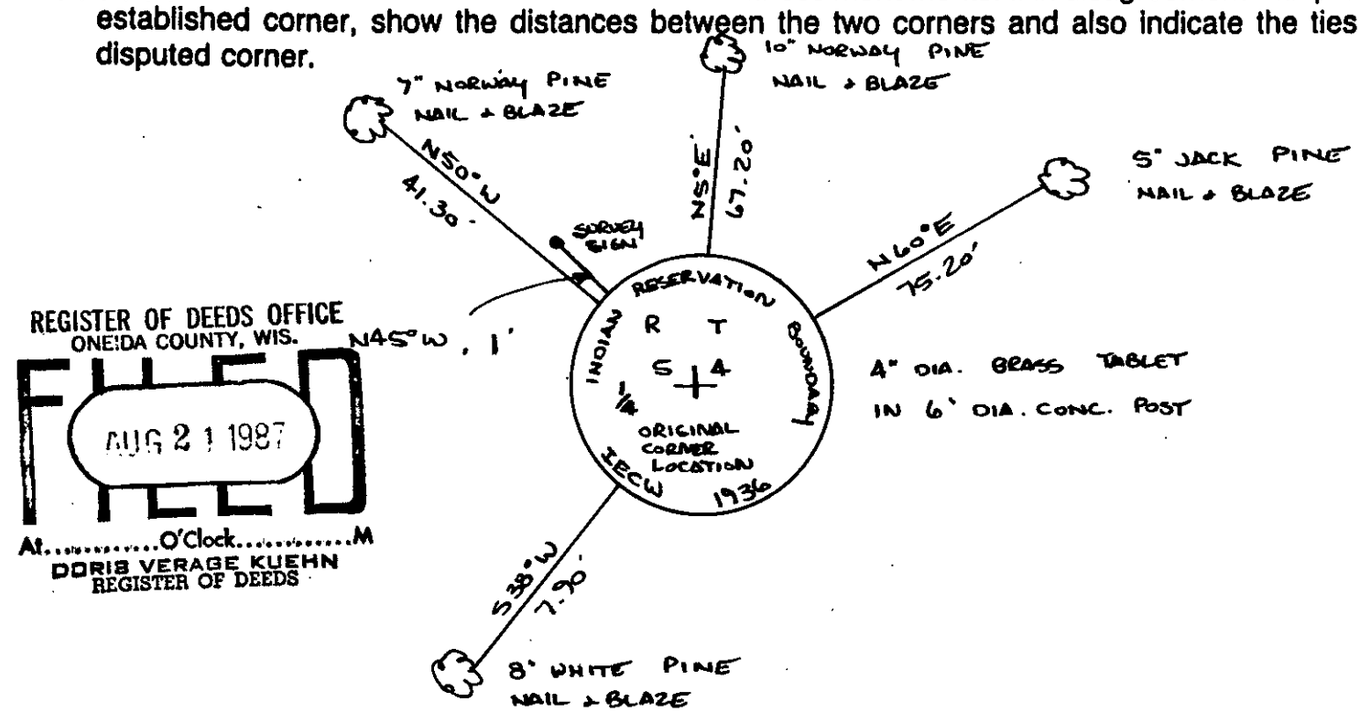

REGISTER OF DEEDS OFFICE
ONEIDA COUNTY, WIS.
FILED
AUG 21 1987
At.....O'Clock.....M
DORIS VERAGE KUEHN
REGISTER OF DEEDS

(i) I, Jeffrey W. Austin
(type or print name) certify that the corner location on this record was determined by me or under my direction and control and that this U.S. Public Land Survey Monument Record is correct and complete to the best of my knowledge and belief.

Jeffrey W. Austin 8-19-87

Signature Date

WISCONSIN
Jeffrey W. Austin
S—1885
Minocqua, WIS.
LAND SURVEYOR

Index No. C9

390605 2000