

CERTIFIED LAND CORNER RESTORATION

State of Wisconsin }  
 County of Oneida } ss.

I Jerome N. Kraemer, do hereby certify that on the 13th day of July, 1981, I found evidence of the North Meander corner corner of Sections 7 and 8 Township 39 North, Range 6 East, Fourth Principal Meridian, as described hereon; and that from this evidence I established a new monument and accessories as described hereon to perpetuate the original location of this corner:

Description of original monument and accessories and subsequent restorations:

Original corner, a wood post, was established in September, 1863 by Alex Anderson, Government Deputy Surveyor

Forrest R. Wincentzen, S-0155, Deputy County Surveyor of Oneida County records on a map of survey of Government Lot 3, undated,

"M.C 4" x 4" Post  
 Pine 22 S2 E 5-3/4 (3.8')  
 Pine 24 S7 E 10 (6.6')

Y. Pine 10 N86 1/2 W 69 links  
 Y. Pine 9 N55 E 8 links

Description of corner evidence found:



I found two 20" diameter Norway Pines with old blaze mark and scribe marks visible. From these two bearing trees I measured N20W, 3.8 feet and N70W, 6.6 feet and locate area for search. After scraping area clear with shovel I find square hole, rooted in, with rotted remains of post point. Wincentzen records 0 88 chains south to S 1/16 corner position in lake. I locate position 0.901 chains south to S 1/16 corner position in lake.

Description of monument and accessories I established to perpetuate the original location of this corner:

August 6, 1981. I replaced remains of old rotted post with a 2" diameter, 30" long clover shaped bottom, aluminum Berntsen Model A-1 standard monument with a 3/4" diameter cast cap stamped to identify corner. Both cap and base encompass permanent magnets

Established new bearing trees:

Set P.K. nail in old existing scribed blaze of N.Pine 20" S90W, 3.14 feet  
 Set P.K. nail in old existing scribed blaze of N.Pine 20" S49E, 5.62 feet  
 Set P.K. nail in new blazed and scribed N.Pine 7" N75E, 26.61 feet.

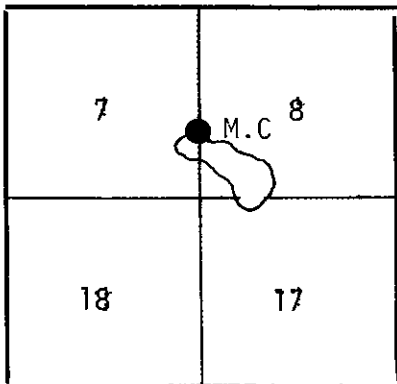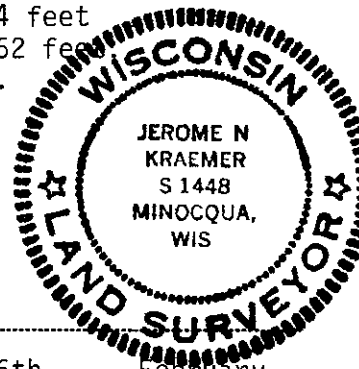

● = Corner monument restored  
 □ =

Resident witnesses .....  
 Dated at Minocqua, Wisconsin, this 26th day of February, 1982.  
 Signature *Jerome N. Kraemer* Title Registered Land Surveyor  
 (County Surveyor, Registered Land Surveyor, or other duly authorized official)  
 Surveyors Registration No. S-1448  
 Office of Register of Deeds County of Oneida  
 I hereby certify that the within instrument was filed in this office for record on the 17th day of March, 1982, and was filed in Book No. .... Page No. .... of County Records.  
 Signature *Louis Terage Kushn* Title Register of Deeds

Township ....., Range ....., Section ....., Index No ....., Page No. ....