

Stock No. 26273

CERTIFIED LAND CORNER RESTORATION

State of Wisconsin }
 County of ONEIDA } ss.

I John H. Fisher, do hereby certify that on the 14th day of August, 1985, I found evidence of the South One Quarter corner of Section 8 Township 39 North, Range 6 East, Fourth Principal Meridian, as described hereon; and that from this evidence I established a new monument and accessories as described hereon to perpetuate the original location of this corner:

Description of original monument and accessories and subsequent restorations:

The original Government was performed by Alexander Anderson, Deputy Surveyor, in 1863.

Wood post:

Aspen	10"	S83-1/2°E	25 lks.
Double Birch	10"	N30°W	29 lks.

Description of corner evidence found:


1-1/2" iron pipe

White Birch	8'	S79°E	11.2 feet
White Birch	6"	N43°W	8.7 feet


Description of monument and accessories I established to perpetuate the original location of this corner:

Replaced 1-1/2" iron pipe with 3" diameter Aluminum Tablet on 2" aluminum pipe, 2.5 feet long.
 Blazed and scribed the following new bearing trees:
 Set nails in:

Maple	9"	S16°W	16.80 feet
White Pine	20"	N82°E	109.40 feet
Maple	8"	N10°E	56.70 feet
White Pine	4"	S15°E	51.70 feet

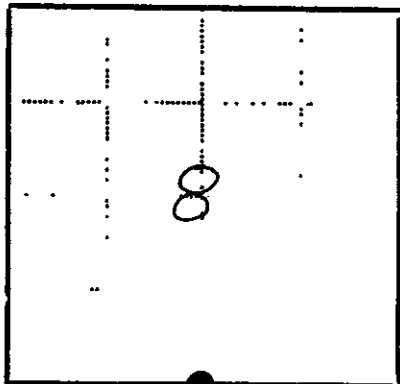

● - Corner monument restored
 □ -

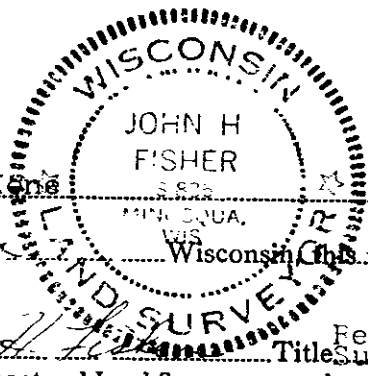

Resident witnesses None
 Signature John H. Fisher Registered Land Surveyor
 (County Surveyor, Registered Land Surveyor, or other duly authorized official)
 Surveyors Registration No. S-836

Office of _____ County of _____
 I hereby certify that the within instrument was filed in this office for record on the _____ day of _____ 19____, and was filed in Book No. _____ Page No. _____ of County Records.

Signature _____ Title _____