

Stock No. 26273

CERTIFIED LAND CORNER RESTORATION

State of Wisconsin }
County of Oneida } ss.

I, John H. Fisher, do hereby certify that on the 19th day of August, 1985, I found evidence of the original location of East Meander corner of Sections 8 and 17, Township T39N, Range 6 East, Fourth Principal Meridian, as described hereon; and that from this evidence I established a new monument and accessories as described hereon to perpetuate the original location of this corner:

Description of original monument and accessories and subsequent restorations:

The original government survey was done by Alexander Anderson, Deputy Surveyor, in 1863.

Wood post set:

Table with 4 columns: Material, Diameter, Bearing, Length. Rows: Tamarack 6" S41-1/2°E 104 lks, Tamarack 5" N44-1/2°E 75 lks

Description of corner evidence found:

None
Corner set on line between One Quarter Corner and Section Corner and 412.29 feet west of One Quarter Corner.


Description of monument and accessories I established to perpetuate the original location of this corner:

Set 3" diameter Oneida County Aluminum Tablet on 2" aluminum pipe, 2.5 feet long. Set Spruce post. Blazed and scribed the following new bearing trees:

Table with 4 columns: Material, Diameter, Bearing, Length. Row: White Pine 14" S74°W 11.3 feet


Set Nail In:

Table with 4 columns: Material, Diameter, Bearing, Length. Rows: Spruce 7" S18°W 5.0 feet, Tamarack 7" S50°E 31.9 feet, Tamarack 7" S39°E 28.6 feet

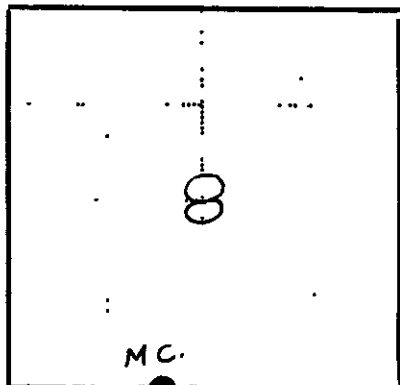

Legend: Circle = Corner monument restored, Square =

Resident witnesses [Signature]
Dated at Lincoln, Wisconsin, on 5th day of Sept 1985.
Signature [Signature] Registered Land Surveyor
(County Surveyor, Registered Land Surveyor, or other duly authorized official)
Surveyors Registration No. S-836

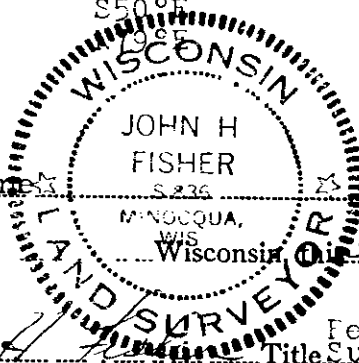

Office of [] County of []
I hereby certify that the within instrument was filed in this office for record on the [] day of [] 19[], and was filed in Book No. [] Page No. [] of County Records.

Signature [] Title []