

U.S. PUBLIC LAND SURVEY MONUMENT RECORD

Index No. N-15

State of Wisconsin }  
County of Oneida } ss.

I, John H. Fisher, do hereby certify that on the 22 day of April 19 85, I found evidence of the North one quarter corner of Section 22 Township 39 North, Range 6 East, Fourth Principal Meridian, as described hereon; and that from this evidence I established a new monument and accessories as described hereon to perpetuate the original location of this corner.

Resident witnesses:

None

History of original corner establishment:


The original Government survey was performed by Alexander Anderson, Deputy Surveyor in 1863.  
Wood post set:

Birch 8" N53°W 18 lks.  
Yellow Pine 15" S 3°E 50 lks.

Description of corner evidence found:

Axel shaft  
Nail in : Norway Pine 6" S31°E 20.5 feet  
Oak 16" S23°W 15.5 feet  
Oak 9" N30°W 22.0 feet  
2" iron pipe West 30.5 feet

Description of monument and accessories I established to perpetuate the original location of this corner. Replaced Axel Shaft with Oneida County 2" aluminum pipe 2.5 feet long with 3" diameter aluminum tablet stamped to identify corner.

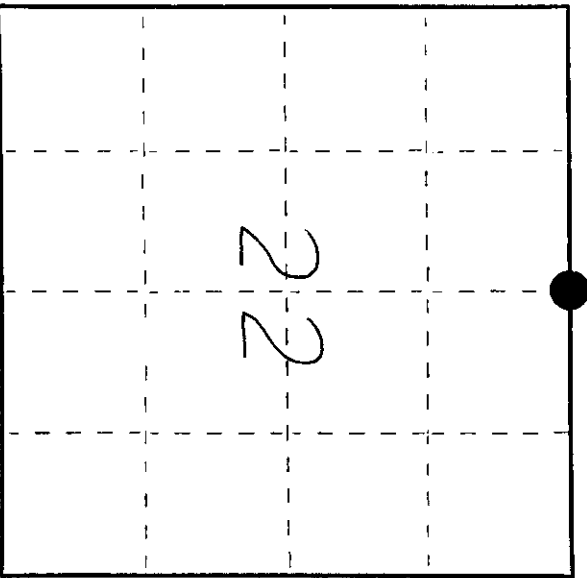

● = Corner monument restored.

Dated at Minocqua, Wis., this 22 day of May, 1985.

Signature: *John H. Fisher* Title Registered Land Surveyor Registration No. S-836  
(County Surveyor, Registered Land Surveyor, or other duly authorized official)

Office of Register of Deeds, County of Oneida  
at 8:00 o'clock A.M. I hereby certify that the within instrument was filed in this office for record on the 19 day of June, 1986

By: *David L. ...* Register of Deeds  
*Suparna A. Biswas* Deputy

3906150020

