


U.S. PUBLIC LAND SURVEY MONUMENT RECORD

Note: This form is intended and designed to fulfill all requirements of Wisconsin Administrative Code, Chapter A-E 5.02, U.S. Public Land Survey Monument Record (3) (a) (b) (c) (d) (e) (f) (g) (h) (i). An additional sheet may be added if necessary to conform with said requirements.

(a) Corner location: Township 39 North
 Range 6 East/West
 Town/City/Village Minocqua
 County Oneida

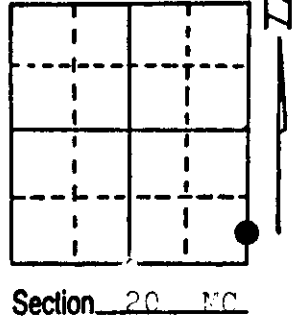

(b) (f) (g) (h) Description of monument found at this corner and if it was accepted, state all evidence (material, testimonial, occupational, plats, records, other monuments) used as a basis for accepting. If not accepted or if nothing was found, state evidence used as basis for establishing location. If reestablished through lost corner proportionate methods, indicate all monuments, distances and directions used to establish.

Found and accepted 1"x60" iron pipe with old wood post scribed MC S20 S21. (Pipe called for in abutting subdivision). Existing PTs:

- Norway Pine 14" (used for new PT)
- Norway Pine 12" (used for new PT)
- Norway Pine 13" (used for new PT)

Original survey performed by Alexander Anderson in October, 1863.



Wood post set:

- Pirch 8" N25°E 15 links
- Pirch 8" S9°W 7 links

(c) (d) (e) Plan view of corner with ties to at least 4 witness monuments. If in disagreement with previously established corner, show the distances between the two corners and also indicate the ties to the disputed corner.

Bearing trees blazed and scribed-distances to nail in tree.

T = SURVEY MARKER SIGN BOBCAT LAKE SHORE: NORTH S.O'

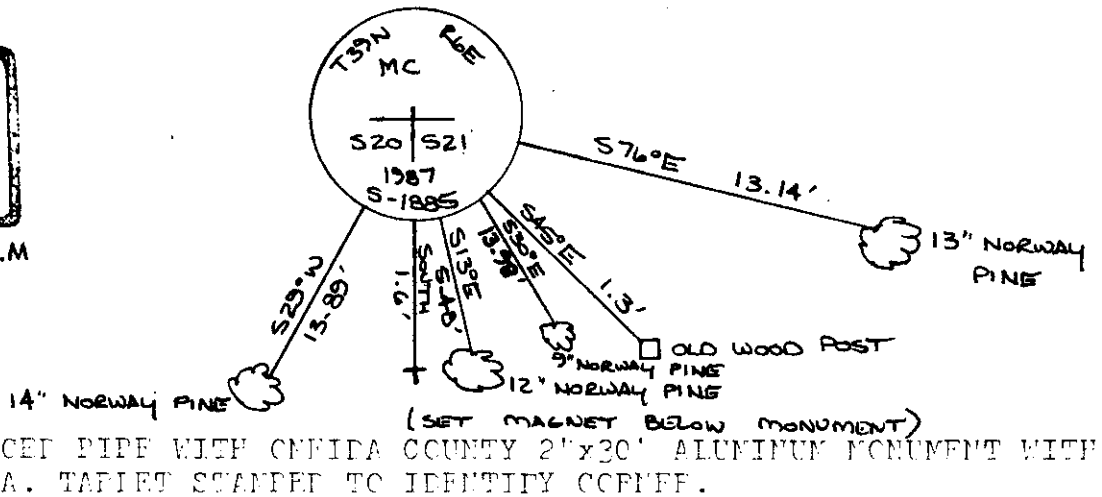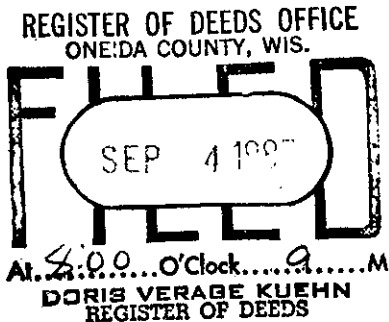

REPLACED PIPE WITH ONEIDA COUNTY 2"x30" ALUMINUM MONUMENT WITH 3" DIA. TABLET STAMPED TO IDENTIFY CORNER.
 (SET MAGNET BELOW MONUMENT)

(i) I, Jeffrey W. Austin
 (type or print name) certify that the corner location on this record was determined by me or under my direction and control and that this U.S. Public Land Survey Monument Record is correct and complete to the best of my knowledge and belief.

Jeffrey W. Austin Signature 8-30-87 Date



Index No. 912-9

3906200400