



Stock No. 26273

U.S. PUBLIC LAND SURVEY MONUMENT RECORD

Index No. P-9

State of Wisconsin } ss.
County of Oneida

History of original corner establishment:
The original Government Survey was performed by Alexander Anderson,
Deputy Surveyor in 1863.
Wood post set:

Aspen	10"	N9-1/2°E	29 lks.
Aspen	10"	N53-1/2°W	9 lks.

I John H. Fisher, do hereby certify that on the 15th day of April 19 85, I found evidence of the one quarter corner of Section 20 and 21 Township 39 North, Range 6 East, Fourth Principal Meridian, as described hereon; and that from this evidence I established a new monument and accessories as described hereon to perpetuate the original location of this corner.

Resident witnesses:

None


Description of corner evidence found:
1" iron pipe

Oak	9"	South	15.5 feet
Oak	13"	N20°W	18.7 feet
Norway Pine	13"	N43°E	8.2 feet

Description of monument and accessories I established to perpetuate the original location of this corner.

Replaced 1" iron pipe with 3" diameter aluminum tablet on 2" aluminum pipe, 2.5 feet long, stamped to identify corner.
Set nail in:

Norway Pine	12"	N69°E	15.5 feet
-------------	-----	-------	-----------

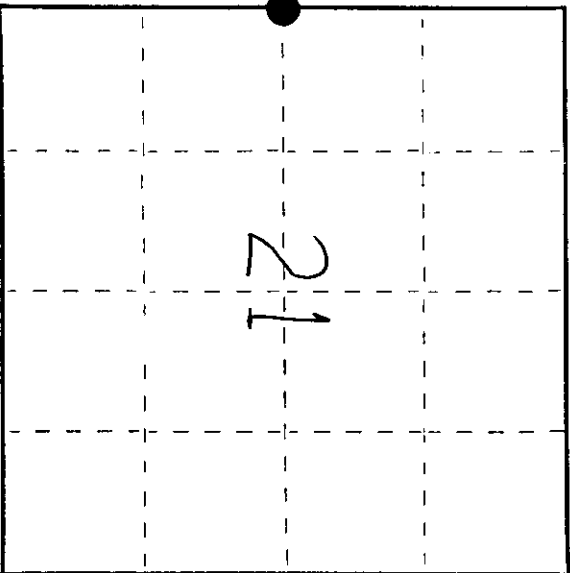

● = Corner monument restored.

Dated at Minocqua, Wis., this 15th day of May, 1985.

Signature *John H. Fisher* Title Registered Land Surveyor Registration No. S-836
(County Surveyor, Registered Land Surveyor, or other duly authorized official)

Office of Register of Deeds, County of Oneida
Instrument was filed in this office for record on the 15th day of June, 1985 at 2:00 o'clock P.M.

By *Doris Norweg* (Register of Deeds) *James A. Burns* Deputy

3906202000

