

Stock No. 26273

CERTIFIED LAND CORNER RESTORATION

State of Wisconsin }
County of Oneida } ss.

I, John H. Fisher, do hereby certify that on the 7th day of October, 1986, I found evidence of the One Quarter corner of Section 21 & 28 Township 39 North, Range 6 East, Fourth Principal Meridian, as described hereon; and that from this evidence I established a new monument and accessories as described hereon to perpetuate the original location of this corner:


Description of original monument and accessories and subsequent restorations:

The original Government Survey was performed by Alexander Anderson, Deputy Surveyor in October 1863.

Set Wood Post:

Aspen 8" S6°E 5 links
Yellow Pine 7" N14°W 23 links

REGISTER OF DEEDS OFFICE ONEIDA COUNTY, WIS.

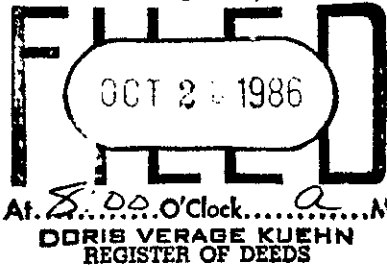

Description of corner evidence found:

3" X 4" Concrete Monument

Norway Pine 9" S20°E 11.9 feet
Double Oak 9" N48°E 12.9 feet
1-1/2" Iron Pine Southwest 0.35 feet

Description of monument and accessories I established to perpetuate the original location of this corner:


Replaced concrete monument with Oneida County 2" diameter aluminum pipe 30" long, with a 3" diameter aluminum tablet stamped to identify the corner.

Set nail in BT's found:

Norway Pine 9" S20°E 11.9 feet
Double Oak 9" N48°E 12.9 feet

Set nail in new BT's:

White Pine 9" N36°W 19.5 feet
Norway Pine 11" S37°W 69.9 feet

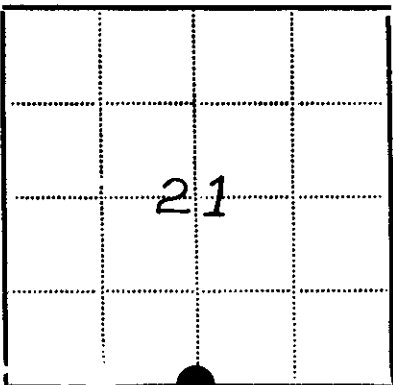

● - Corner monument restored
□ -

Resident witnesses.....

Dated at Minocqua Wisconsin, this 13 day of October, 1986

Signature [Handwritten Signature] Title Registered Land (County Surveyor, Registered Land Surveyor, or other duly authorized official)

Surveyors Registration No. S-836

Office of.....County of..... I hereby certify that the within instrument was filed in this office for record on the.....day of.....19....., and was filed in Book No.....Page No.....of County Records.

Signature.....Title.....

Township....., Range....., Section....., Index No....., Page No.....

3906210020

R-11