U.S. PUBLIC LAND SURVEY MONUMENT RECORD

Note: This form is intended and designed to fulfill all requirements of Wisconsin Administrative Code, Chapter A-E 5.02, U.S. Public Land Survey Monument Record (3) (a) (b) (c) (d) (e) (f) (g) (h) (i). An additional sheet may be added if necessary to conform with said requirements.

(a) Corner location: Township 39 North

Range 6 East/~~West~~

Town/~~City/Village~~ MINOCQUA

County ONEIDA

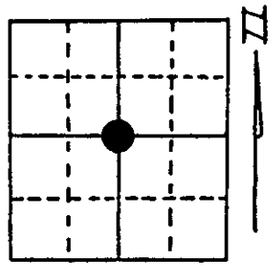

(b) (f) (g) (h) Description of monument found at this corner and if it was accepted, state all evidence (material, testimonial, occupational, plats, records, other monuments) used as a basis for accepting. If not accepted or if nothing was found, state evidence used as basis for establishing location. If reestablished through lost corner proportionate methods, indicate all monuments, distances and directions used to establish.

May 2, 1989 - I found 5" square concrete monument which has been used and accepted in many previous surveys in section 21.

I accepted monument and set 60 penny nails in existing bearing trees:

Red Oak 12" S28W, 40.43 feet (BT tag)
Red Oak 12" S85W, 45.44 feet
Norway Pine 15" N30E, 37.80 feet
Red Oak 13" S77E, 11.94 feet

(c) (d) (e) Plan view of corner with ties to at least 4 witness monuments. If in disagreement with previously established corner, show the distances between the two corners and also indicate the ties to the disputed corner.

1. Red Oak 12" S28W, 40.43'
2. Red Oak 12" S85W, 45.44'
3. Norway Pine 15" N30E, 37.80'
4. Red Oak 13" S77E, 11.94'

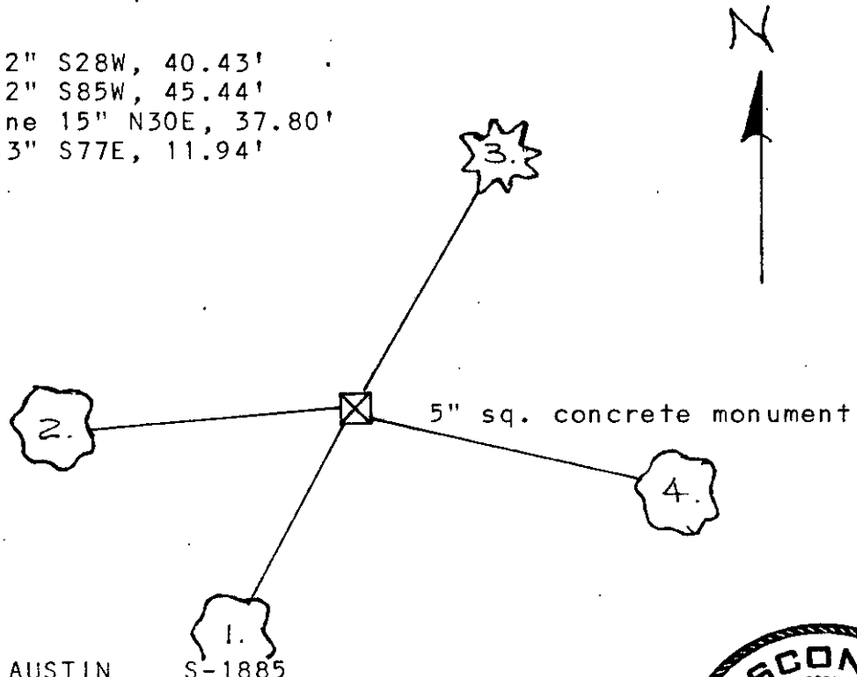

(i) I, JEFFREY W. AUSTIN S-1885 (type or print name) certify that the corner location on this record was determined by me or under my direction and control and that this U.S. Public Land Survey Monument Record is correct and complete to the best of my knowledge and belief.

Signature _____ Date MAY 4, 1989

WISCONSIN
Jeffrey W. Austin
S—1885
Minocqua, WIS.
LAND SURVEYOR

Index No. P-11

3906212020