

# U.S. PUBLIC LAND SURVEY MONUMENT RECORD

Note: This form is intended and designed to fulfill all requirements of Wisconsin Administrative Code, Chapter A-E 5.02, U.S. Public Land Survey Monument Record (3) (a) (b) (c) (d) (e) (f) (g) (h) (i). An additional sheet may be added if necessary to conform with said requirements.


(a) Corner location: Township 39 North

Range 7 East ~~West~~

Town/City/Village of Woodruff

County Oneida

1 1/2" iron pipe

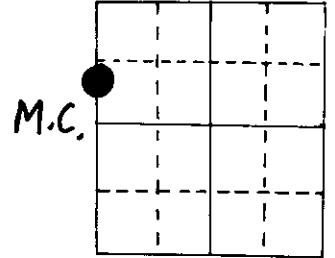

Section 30


(b) (f) (g) (h) Description of monument found at this corner and if it was accepted, state all evidence (material, testimonial, occupational, plats, records, other monuments) used as a basis for accepting. If not accepted or if nothing was found, state evidence used as basis for establishing location. If reestablished through lost corner proportionate methods, indicate all monuments, distances and directions used to establish.

Original Alex Anderson Sept 1860. OBT's BY 6" S 52°W 29 lks, Tam 10" N 89°E 73 lks at 7.54 ch north of 1/4 cor.

Swamp call was at 5.50 ch north of 1/4 then and now with the lake being held by a dam the level is higher, so the present M.C. is at the old swamp call.

I found on 3/5/82 a 1 1/2" i.p. & BT's Heml 16" N 54°E 5.55', Heml 18" S 1°W 7.3'.  
Made two more BT's in Mar. 1984.

(c) (d) (e) Plan view of corner with ties to at least 4 witness monuments. If in disagreement with previously established corner, show the distances between the two corners and also indicate the ties to the disputed corner.

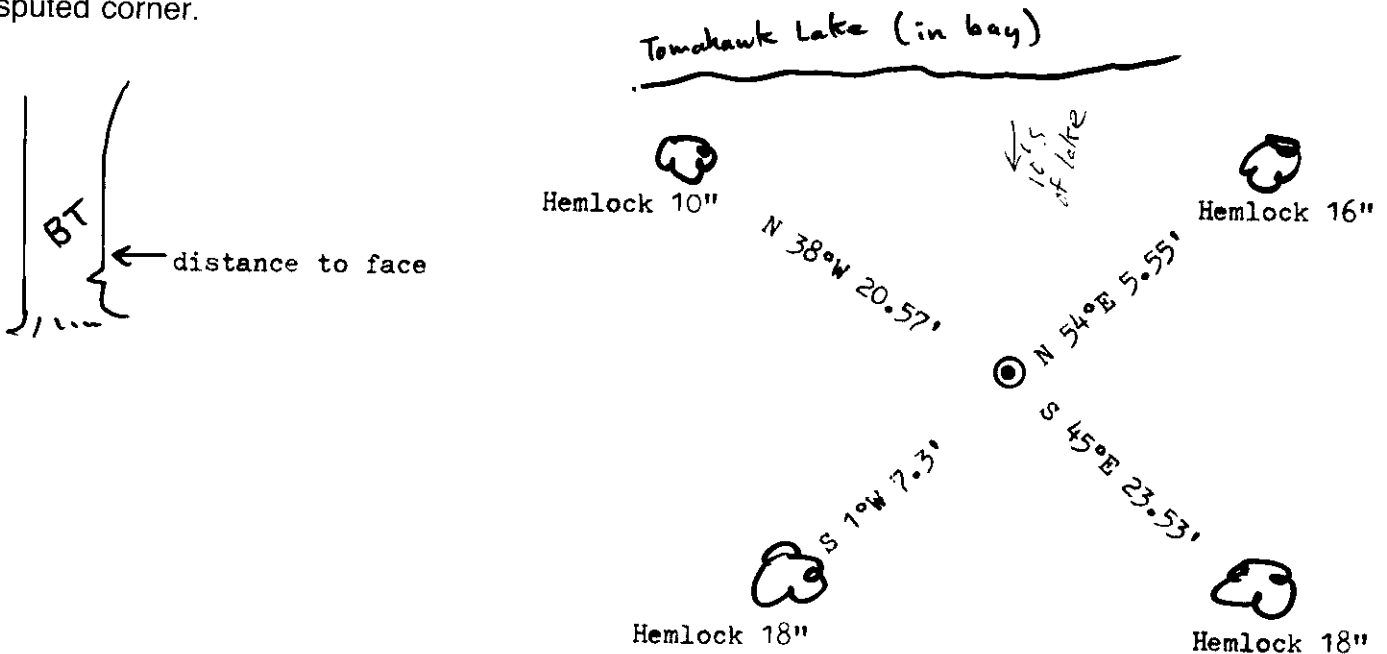

(i) I, Marvin E. Seymour  
(type or print name) certify that the corner location on this record was determined by me or under my direction and control and that this U.S. Public Land Survey Monument Record is correct and complete to the best of my knowledge and belief.

Marvin E. Seymour April 25, 1984  
Signature Date



Affix seal here

5-1

3906252300