

Stock No. 26273

R9-7150-11 (9/1/66)

H. C. MILLER CO., MILWAUKEE 450024

CERTIFIED LAND CORNER RESTORATION

State of Wisconsin }
County of Oneida } ss.

I, John H. Fisher, do hereby certify that on the 7th day of August, 1985, I found evidence of the South One Quarter corner of Section 29 Township 39 North, Range 6 East, Fourth Principal Meridian, as described hereon; and that from this evidence I established a new monument and accessories as described hereon to perpetuate the original location of this corner:

Description of original monument and accessories and subsequent restorations:

The original Government Survey was performed by Alexander Anderson, Deputy Surveyor in 1863. Wood post set:

Table with 4 columns: Tree Type, Diameter, Bearing, Distance. White Pine 16" N45°E 18 lks, Aspen 8" S46°W 5 lks

Description of corner evidence found:

Brass cap stamped to identify corner on 1-1/2" iron pipe.



Table with 3 columns: Evidence, Bearing, Distance. 1-1/2" iron pipe S75°W 16.75 feet

Description of monument and accessories I established to perpetuate the original location of this corner:

Blazed and scribed the following new bearing trees

Set nail in:

Table with 4 columns: Tree Type, Diameter, Bearing, Distance. White Pine 10" N55°E 32.80 feet, Oak 7" S50°E 23.00 feet, Oak 4" S18°W 13.20 feet

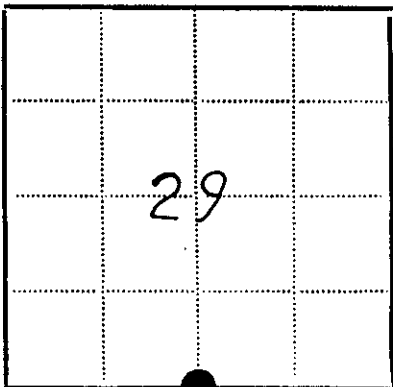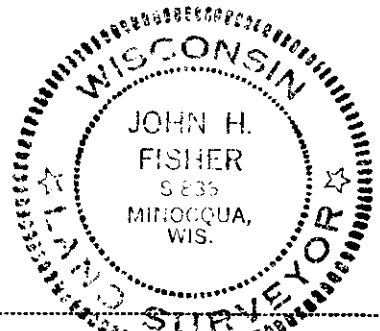

Legend: Circle - Corner monument restored, Square -

Resident witnesses None

Dated at Minocqua Wisconsin, this 21st day of August 1985

Signature John H. Fisher Registered Land Surveyor (County Surveyor, Registered Land Surveyor, or other duly authorized official)

Surveyors Registration No. S-836

Office of County of

I hereby certify that the within instrument was filed in this office for record on the day of 19, and was filed in Book No. Page No. of County Records.

Signature Title

Township, Range, Section, Index No., Page No.

3906290020

1-7