U. S. PUBLIC LAND SURVEY MONUMENT RECORD

Note: This form is intended and designed to fulfill all requirements of Wisconsin Administrative Code, Chapter A-E 7.08 U.S. Public Land Survey Monument Record (3)(a)(b)(c)(d)(e)(f)(g)(h)(i). An additional sheet may be added if necessary to conform with said requirements.

(a) CORNER LOCATION Township 39 North
Range 6 East

Town of Minocqua

County of Oneida, State of Wisconsin

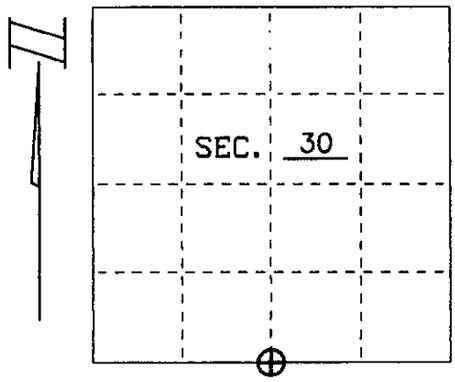

(b)(f)(g)(h) Description of monument found at this corner and if it was accepted, state all evidence (material, testimonial, occupational, plats, records, other monuments) used as a basis for accepting. If not accepted or if nothing was found, state evidence used as basis for establishing location, If reestablished through lost corner proportionate methods, indicate all monuments, distances and directions used to establish. Indicate type of monument and sign post found or set.

Oct. 15–23, 1863 Alexander Anderson, Deputy Surveyor

Original Bearing Trees:
Blk Pine 10" N 57°E 5lks
Blk Pine 10" S 05°W 12lks

Nov. 20, 1996 I found no evidence of the original corner or bearing trees. I established corner position by single proportionate method between opposing section corners. The section corners coordinate positions were measured by GPS and the coordinates were provided to us by Oneida County. I bark scribed the bearing trees as shown below and set carsonite sign post North 1 foot .

(c)(d)(e) Plan view of corner with ties to at least 4 witness monuments. If in disagreement with previously established corner, show the distances between the two corners and also indicate the ties to the disputed.

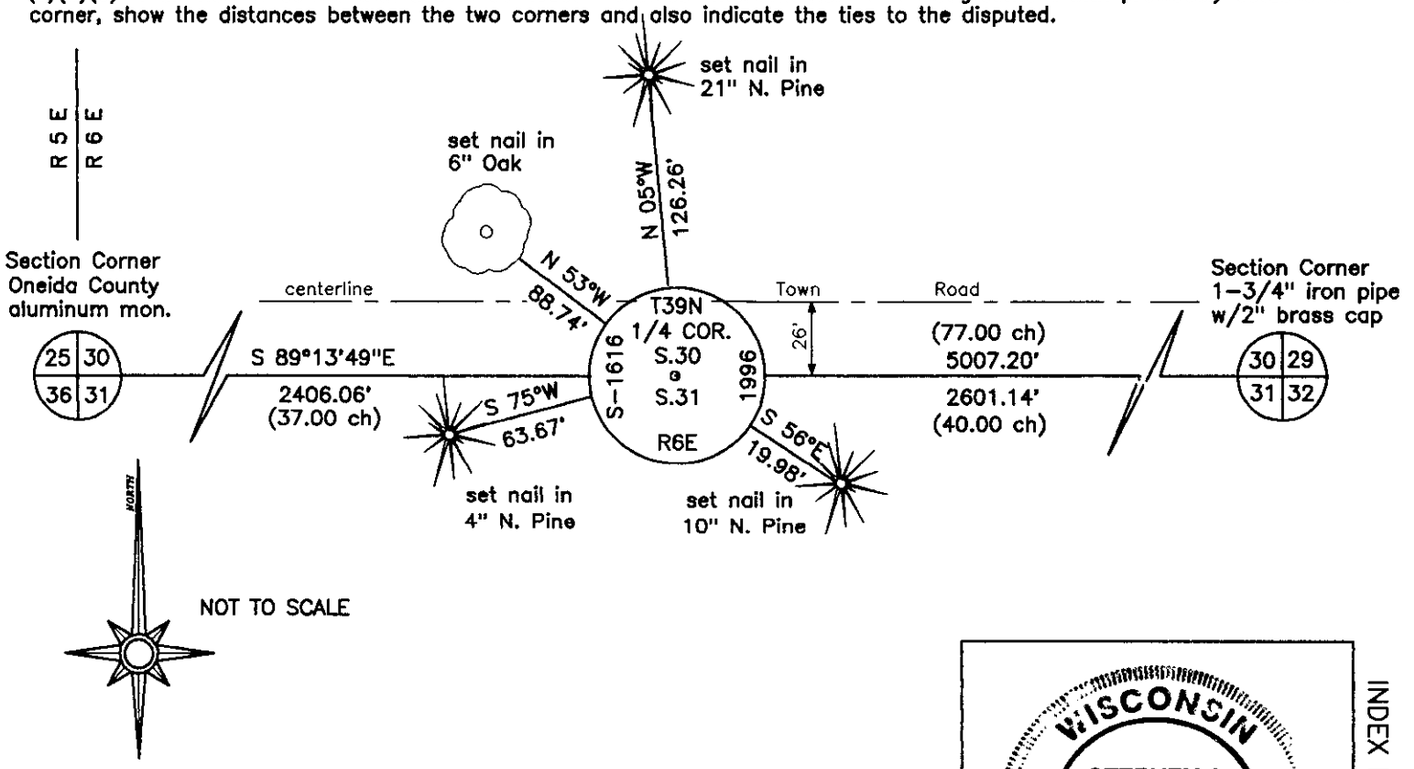

(i) I, Stephen J. Favorite, hereby certify that the corner location on this record was determined by me or under my direction and control and that this U.S. Public Land Survey Monument Record is correct and complete to the best of my knowledge and belief.

Stephen J. Favorite 12/9/96

Stephen J. Favorite
R.L.S. #S-1616

Date

WISCONSIN
STEPHEN J. FAVORITE
S-1616
EAGLE RIVER, WI
LAND SURVEYOR

INDEX NO. V - 3

3906300020