

U. S. PUBLIC LAND SURVEY MONUMENT RECORD


Note: This form is intended and designed to fulfill all requirements of Wisconsin Administrative Code, Chapter A-E 7.08 U.S. Public Land Survey Monument Record(3)(a)(b)(c)(d)(e)(f)(g)(h)(i). An additional sheet may be added if necessary to conform with said requirements.

(a) Corner location: Township 39 North

Range 6 East

Town of Minocqua

Oneida County, Wisconsin

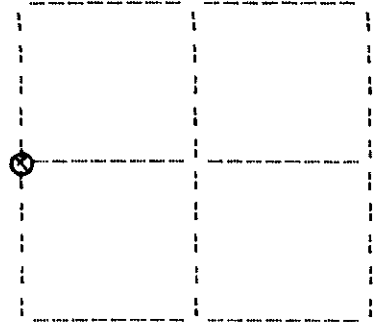

Section 29

(b)(f)(g)(h) Description of monument found at this corner and if it was accepted, state all evidence (material, testimonial, occupational, plats, records, other monuments) used as a basis for accepting. If not accepted or if nothing was found, state evidence used as basis for establishing location. If reestablished through lost corner proportionate methods, indicate all monuments, distances and directions used to establish. Indicate type of monument found or set and sign post.

October, 1863: Alexander Anderson, US deputy surveyor notes the following: 40.00 set 1/4 sec. post: blk.pine 12 S38W, 11 lks; aspen 7 N71E, 21 lks.


October 24, 1929: Hall page 59 notes the following: 39.03 hub on said 1' offset. search for this 1/4 cor. stumps badly burned. find nothing. 39.234 rt angle Ely 1.115(1.129-.014) & drive iron bar & pine post for 1/4 sec cor 29&30. this cor comes at S edge green timber & midway up NW slope of pothole. w.pine 15" N42-40E, .69 = 45.5; w.pine 18" N35-1/4W, .71 = 46.9'.

September 12, 1990: I found and accepted a 1" sq. iron bar at corner of pothole per hall's description. I replaced said bar with a 2-1/2" dia. aluminum post, 20" in the ground with 3-1/4" dia. aluminum cap marked as shown below. I found the following witnesses: 1-1/2" dia. iron pipe N38W, 34.45 feet; axed pine stump(hall) N47E, 46.1 feet; axed pine stump(hall) N35W, 47.5 feet; w.birch stump S53E, 8.5 feet. I established the following witnesses: set nail in oak 5" N29E, 34.88 feet; set nail in w.birch 11" N65E, 17.75 feet; set nail in w.birch 8" S72E, 19.63 feet; set plastic sign post north, 1 foot.

(c)(d)(e) Plan view of corner with ties to at least four witness monuments. If in disagreement with previously established corner, show the distances between the two corners and also indicate the ties to the disputed corner.

1. nail in oak 5"
N29E, 34.88 feet
2. nail in w.birch 11"
N65E, 17.75 feet
3. nail in w.birch 8"
S72E, 19.63 feet
4. 1-1/2" dia. iron pipe
N38W, 34.45 feet

(not to scale)

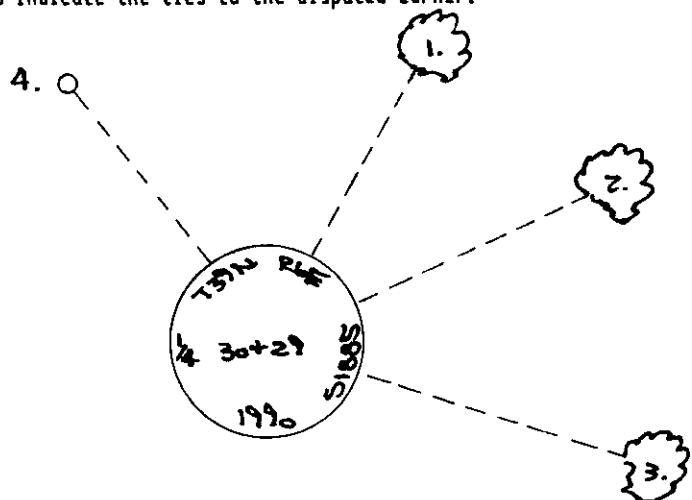

I, Jeffrey W. Austin, Registered Land Surveyor S-1885 certify that the corner location on this record was determined by me or under my direction and control and that this U.S. Public Land Survey Monument Record is correct and complete to the best of my knowledge and belief.



Signature: *Jeffrey W. Austin* Date: September 30, 1990

Index no. T-5

3906302000