

CERTIFIED LAND CORNER RESTORATION

State of Wisconsin }
County of Oneida } ss.

we I Gerald B. Inman, do hereby certify that on the 12th day of June, 19 81, ~~found~~ evidence of the West 1/4 corner of Section 33 Township 39N Range 6E, Fourth Principal Meridian, as described hereon; and that ~~from this evidence~~ I established ~~a new monument and~~ accessories as described hereon to perpetuate the original location of this corner:

Description of original monument and accessories and subsequent restorations:


- Wood post
- 7" Birch, N57°E, 14 links
- 7" Birch, S39°W, 20 links

Description of corner ~~evidence~~ found:

- Angle iron

Description of ~~monument and~~ accessories ~~I~~ established to perpetuate the location of this corner:

- Angle iron monument
- Pine stump, N70°E, 1 foot
- Pine stump, S13°W, 24.5 feet
- Oak Stump, North 10.9 feet

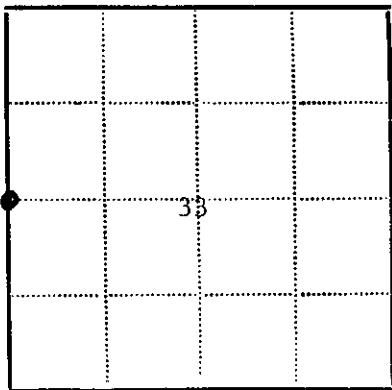

● - Corner monument restored
□ -

~~Resident~~ witnesses Robert W. Conner, Jr.

Dated at Minocqua Wisconsin, this 12th day of June 19 81.

Signature *Gerald B. Inman* Title R.L.S.
(County Surveyor, Registered Land Surveyor, or other duly authorized official)

Surveyors Registration No. S-891

Office of *Reg. of Deeds* County of *Oneida*

I hereby certify that the within instrument was filed in this office for record on the 12 day of June 19 81, and was filed in Book No. Page No. of County Records.

Signature *Doris V. Kuhn* Title *Reg. of Deeds*
Cynthia A. West Deputy

Township, Range, Section, Index No., Page No.

6-X