

At 8:00 O'clock P.M.

DORIS VERAGE KUEHN  
REGISTER OF DEEDS

FORM 303 H. C. MILLER CO., MILWAUKEE

State of Wisconsin

County of Oneida


ss.

I James D. Rein do hereby certify that on the 28th day of February 19 79, I found evidence of the northeast corner of Section 2 Township 32 North, Range 6 East, Fourth Principal Meridian,

as described hereon; and that from this evidence I established a new monument and accessories as described hereon to perpetuate the original location of this corner.

Resident witnesses:

None

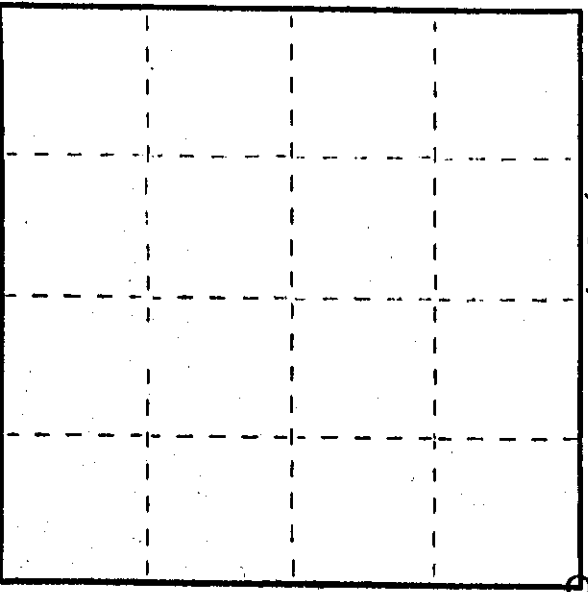

O = Corner monument restored.

CERTIFIED LAND CORNER RESTORATION

Index No. A-21

History of original corner establishment:

Wood post set by Alfred Millard on September 19th, 1860, witnessed by the following bearing trees:  
30" White Pine S31°E, 122 links (90.52 feet); 12" Tamarack S2L°W, 82 links (51.12 feet); 4" Tamarack N7L°W, 30 links (19.80 feet); 4" Spruce, N69°E, 37 links (24.42 feet)

Description of corner evidence found: Wood post with P.K. nail in center. Remains of original 30" White Pine stump, lower face scribed 72", S33°E, 79.51 feet; Remains of stump S21°W, 54 feet; Other trees are gone. Corner is located in swamp overflowed by the waters of Tamarack Lake.

Description of monument and accessories I established to perpetuate the original location of this corner.  
Set two Aluminum Oneida County Survey Markers (Bernstein Monuments 2" diameter and 30" long with a 3-1/4" diameter cap) as witness corners to the wood post.  
Set Witness Corner No.1 on the north line of Section 2 at a distance of 100.00 feet West of the wood post witnessed by the following scribed bearing trees: Set P.K. nail in an 8" White Birch S23°E, 16.55 feet; set P.K. nail in a 7" Oak, S55°W, 19.48 feet; set P.K. nail in a 7" White Birch N69°W, 19.95 feet.  
Set Witness corner No.2 on the north line of Section 2 at distance of 180.00 feet west of the wood post witnessed by the following scribed bearing trees: Set P.K. nail in a 6" Oak S52°E, 29.99 feet; set P.K. nail in an 8" Oak, S41°W, 26.58 feet; Set P.K. nail in a 9" Oak N7L°E, 11.81 feet.

Dated at Minocqua Wis. this 12th day of March 19 79

(County Surveyor, Registered Land Surveyor, or other duly authorized official)  
Oneida  
Office of Register of Deeds, County of Oneida  
I hereby certify that the within instrument was filed in this office for record on the 19 day of 19 at o'clock M.

(Register of Deeds)

By Deputy

3906350000