


REGISTER OF DEEDS OFFICE
ONEIDA COUNTY, WIS.

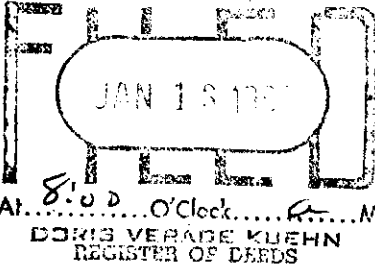

FORM 983 M. C. M. CO., MILWAUKEE


State of Wisconsin }
County of Oneida } ss.

I, James D. Rein, do hereby certify that on the 17th day of January, 1979, I found evidence of the North one-quarter corner of Section 2 Township 38 North, Range 6 East, Fourth Principal Meridian, as described hereon; and that from this evidence I established a new monument and accessories as described hereon to perpetuate the original location of this corner.

Resident witnesses:

None

Section 2, T38N, R6E

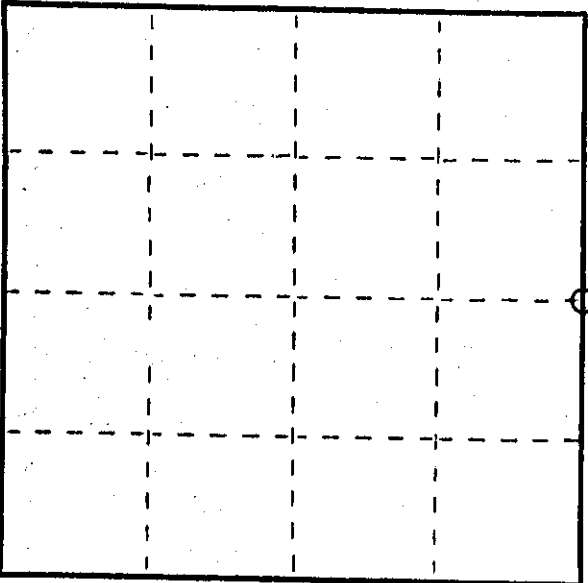

○ = Corner monument restored.

CERTIFIED LAND CORNER RESTORATION

Index No. A-19

History of original corner establishment: Wood post set by Alfred Willard on September 19, 1860, witnessed by the following bearing trees: 12" Aspen S68°W, 11 links (9.24 feet); 9" white pine N18°E, 20 links (13.20 feet)
Map of "Pottawattonie Forest and Adjoining Lands" by E.F. Kowalke dated January, 1951 legends the corner as being a 1-1/2" iron pipe and post witnessed by a 15" Oak bearing N52°E, 7.0 feet and by a 5" Oak bearing South, 12.2 feet.

Description of corner evidence found:

Old 4" x 4" scribed cedar post and 1-1/2" inside diameter iron pipe up 1-1/2 feet which is 0.80 feet South of post; Post is witnessed by a 16" Oak bearing N51°-29'E, 7.00 feet and by an 9" Oak, S3°-10'W, 12.20 feet.

Description of monument and accessories I established to perpetuate the original location of this corner.

Set a 2" diameter x 33" long Bernsten monument with a 3-1/4" diameter cast aluminum Oneida County cap up 1 foot to replace cedar post. Corner is located 60 feet south and 285 feet west of logging road.
Witnessed by the following bearing trees:
P.K. nail in 16" Oak bearing N51°-29'E, 7.00 feet
P.K. nail in 8" Oak bearing S 3°-10'W, 12.20 feet
P.K. nail in a scribed 5" Maple bearing S49°-08'E, 35.53 feet


Dated at Minocqua, Wis., this 12th day of March, 1979

(County Surveyor, Registered Land Surveyor, or other duly authorized official)

Office of Register of Deeds, County of Oneida
Instrument was filed in this office for record on the _____ day of _____, 19____ at _____ o'clock _____ M. I hereby certify that the within

(Register of Deeds)

By: _____ Deputy

3906350020