


U.S. PUBLIC LAND SURVEY MONUMENT RECORD

Note: This form is intended and designed to fulfill all requirements of Wisconsin Administrative Code, Chapter A-E 5.02, U.S. Public Land Survey Monument Record (3) (a) (b) (c) (d) (e) (f) (g) (h) (i). An additional sheet may be added if necessary to conform with said requirements.

(a) Corner location: Township 38 North
 Range 6 East ~~_____~~

W.M.C.

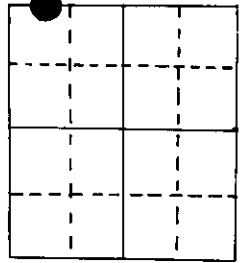

Town/~~City/Village~~ Hazelhurst

County Oneida

Section 1

3/4 " iron pipe


(b) (f) (g) (h) Description of monument found at this corner and if it was accepted, state all evidence (material, testimonial, occupational, plats, records, other monuments) used as a basis for accepting. If not accepted or if nothing was found, state evidence used as basis for establishing location. If reestablished through lost corner proportionate methods, indicate all monuments, distances and directions used to establish.

Original Alex Anderson Sept 1860. OBT's PW 24" North 30 lks, B Oak 10" S 18°W 35 lks at 8.92 ch east of NW 1.

Hennig in Nov. 1947 found iron pipe, Oak S 13°W 13.9' is marked.
 Dorr had 574.2' east of NW 1
 i.p. is 558.8' east of NW 1 accepted i.p. as correct as anyone can be.
 Made new BT's Oak 3" N 30°W 3.9'

I found on 3/16/84 the 3/4 " iron pipe & both BT's. Tied house to i.p.

(c) (d) (e) Plan view of corner with ties to at least 4 witness monuments. If in disagreement with previously established corner, show the distances between the two corners and also indicate the ties to the disputed corner.

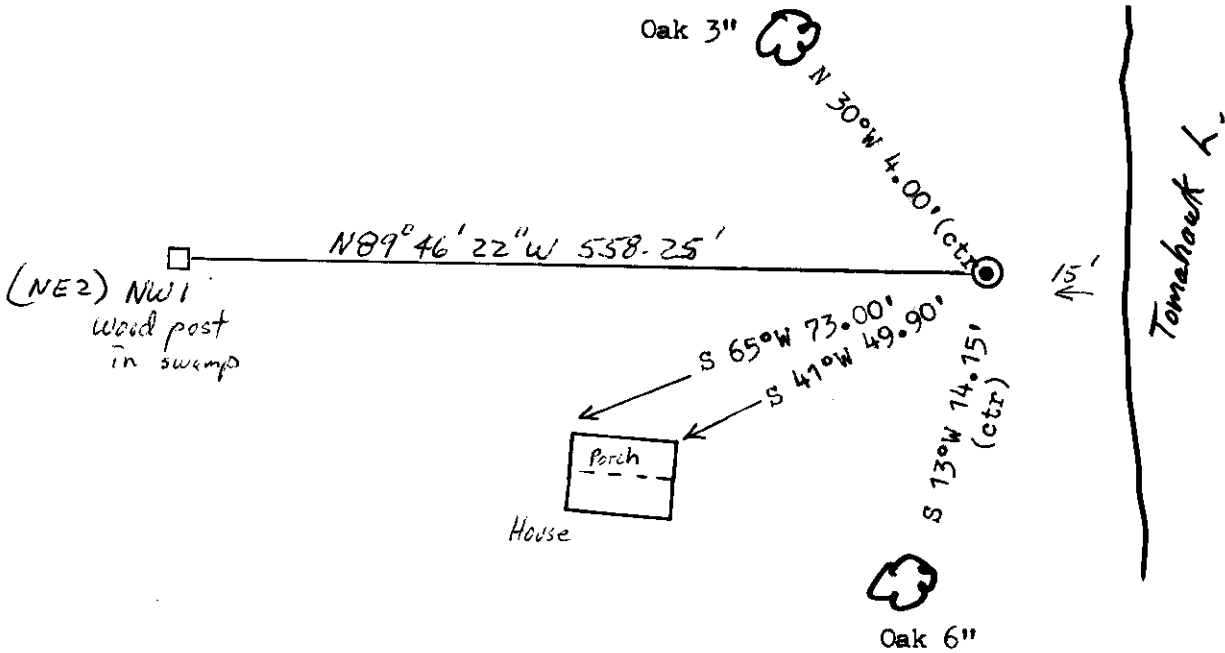

(i) I, Marvin E. Seymour
 (type or print name) certify that the corner location on this record was determined by me or under my direction and control and that this U.S. Public Land Survey Monument Record is correct and complete to the best of my knowledge and belief.

Marvin E. Seymour April 26, 1984
 Signature Date



A-21(m)22