


U.S. PUBLIC LAND SURVEY MONUMENT RECORD

Note: This form is intended and designed to fulfill all requirements of Wisconsin Administrative Code, Chapter A-E 5.02, U.S. Public Land Survey Monument Record (3) (a) (b) (c) (d) (e) (f) (g) (h) (i). An additional sheet may be added if necessary to conform with said requirements.

(a) Corner location: Township 39 North
 Range 7 East/~~West~~

Town ~~Woodruff~~ of Woodruff

County Oneida

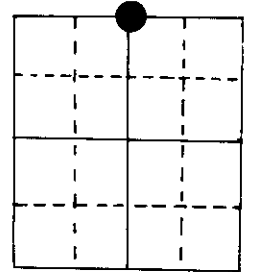

N¹/₄ Section 11

2" iron pipe with W.C .D. brass cap

(b) (f) (g) (h) Description of monument found at this corner and if it was accepted, state all evidence (material, testimonial, occupational, plats, records, other monuments) used as a basis for accepting. If not accepted or if nothing was found, state evidence used as basis for establishing location. If reestablished through lost corner proportionate methods, indicate all monuments, distances and directions used to establish.


Original Alex Anderson Sept 1863. OBT's Tam 7" N 64°E 13 lks, Tam 8" S 70°E 20 lks

Vaughn on 11/12/01 at 75.24 north of S¹/₄ cor fell 81 east of N¹/₄ post, found orig. trees and marked them again.


Berndt on 4/14/61 found OBT & set W.C.D. pipe. New BT's PW 12" S 39°E 0.64 ch
 at 39.693 west of N E cor PN 5" N 64°E 0.330 ch
 & 39.489 east of NW cor

I found wcd brass cap on 2/21/83, made BT's on March 1984 SB 4" N 3°W 28.88'
 BT's dead and fell over. SB 8" N 74°E 17.31'
 FW 10" S 74°E 23.58'
 Tam 4" S 32°E 27.03'

(c) (d) (e) Plan view of corner with ties to at least 4 witness monuments. If in disagreement with previously established corner, show the distances between the two corners and also indicate the ties to the disputed corner.

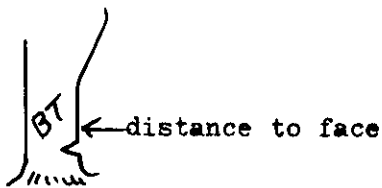


B Spruce 4"

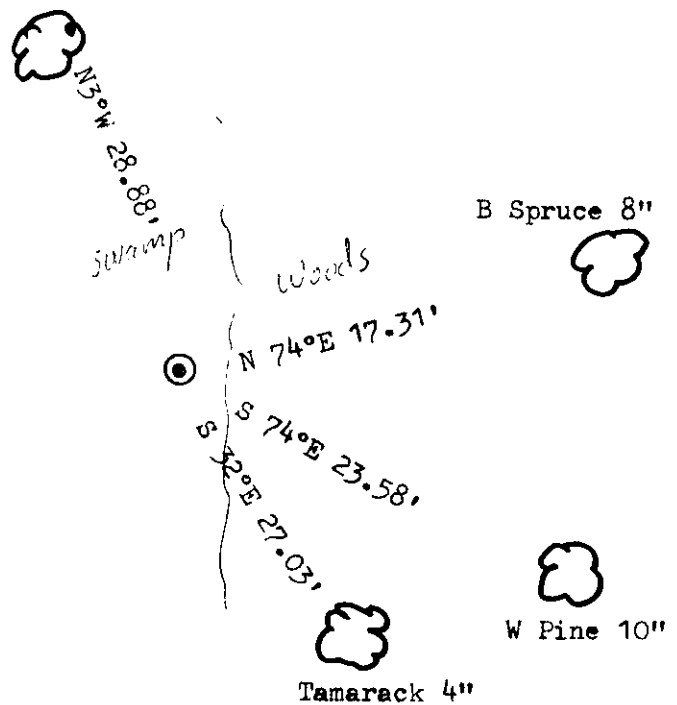

(i) I, Marvin E. Seymour
 (type or print name) certify that the corner location on this record was determined by me or under my direction and control and that this U.S. Public Land Survey Monument Record is correct and complete to the best of my knowledge and belief.

Marvin E. Seymour April 12, 1984
 Signature Date

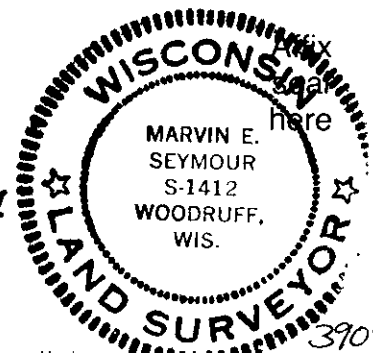

E-19

3907020020