

U.S. PUBLIC LAND SURVEY MONUMENT RECORD


Note: This form is intended and designed to fulfill all requirements of Wisconsin Administrative Code, Chapter A-E 5.02, U.S. Public Land Survey Monument Record (3) (a) (b) (c) (d) (e) (f) (g) (h) (i). An additional sheet may be added if necessary to conform with said requirements.

(a) Corner location: Township 39 North

Range 7 East

Town Woodruff of Woodruff

County Oneida

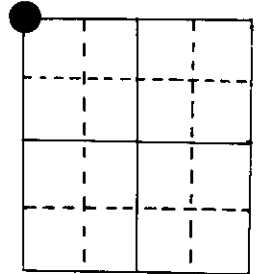

NW_{cor} Section 11

2" iron pipe with D.N.R. brass cap

(b) (f) (g) (h) Description of monument found at this corner and if it was accepted, state all evidence (material, testimonial, occupational, plats, records, other monuments) used as a basis for accepting. If not accepted or if nothing was found, state evidence used as basis for establishing location. If reestablished through lost corner proportionate methods, indicate all monuments, distances and directions used to establish.

Original Alex Anderson Sept 1863. OBT's PW 8" N 73°E 104 lks, PW 8" N 60°W 117 lks

Vaughn on 11/8/01 found NE OBT is OK, NW OBT gone. Post sets in wet marsh, almost pond.


Berndt on 4/12/61 set W.C.D. pipe using Vaughn's N¼ 10 and E 1/16 and doubling over to NE 10(NW 11). Made BT's PW 8" N 54°W 1.47 ch, PW 17" S 13°E 2.05 ch.

On 2/14/83 found erroneous 2" i.p. w/insert. Does not match to BT's that are there. I used Berndt's BT distances to reset a new brass cap as his is gone.

Berndt's BT's in good condition with scribing. I made two new BT's.


Distance south to swamp edge matches original.

(c) (d) (e) Plan view of corner with ties to at least 4 witness monuments. If in disagreement with previously established corner, show the distances between the two corners and also indicate the ties to the disputed corner.

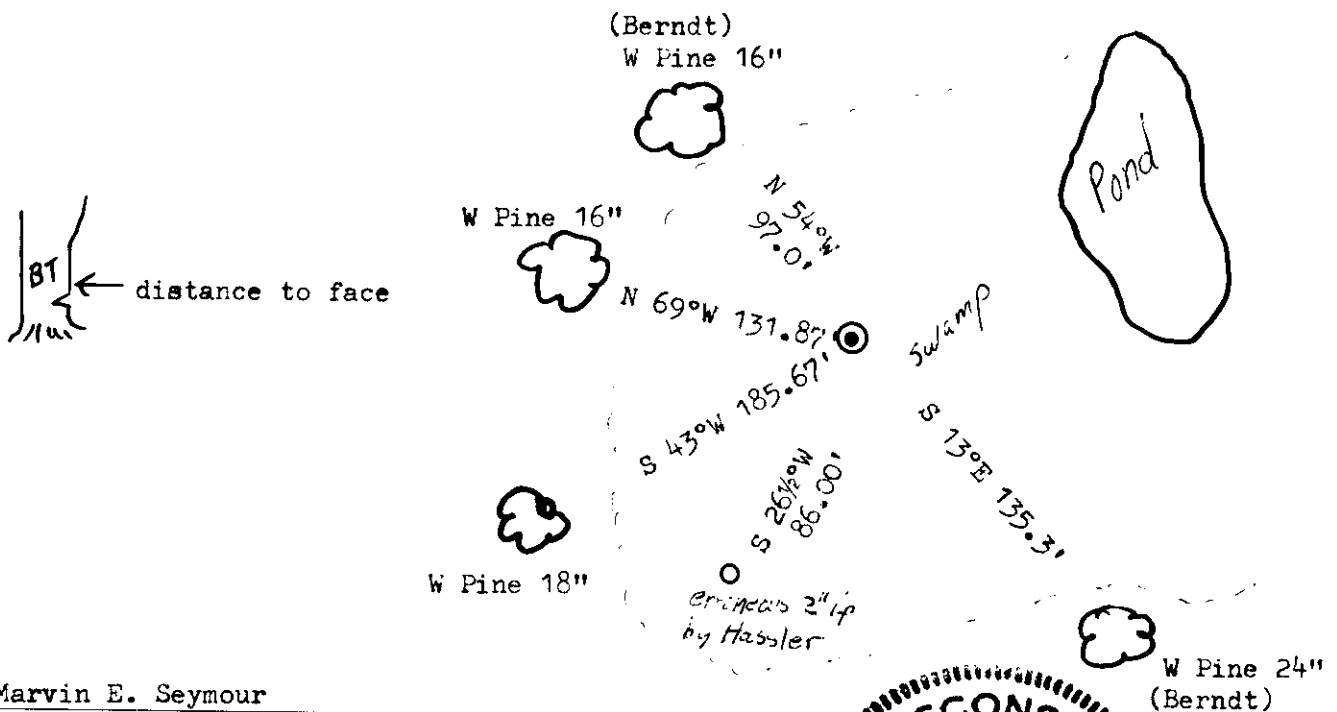

(i) I, Marvin E. Seymour
 (type or print name) certify that the corner location on this record was determined by me or under my direction and control and that this U.S. Public Land Survey Monument Record is correct and complete to the best of my knowledge and belief.

Marvin E. Seymour April 12, 1984
 Signature Date

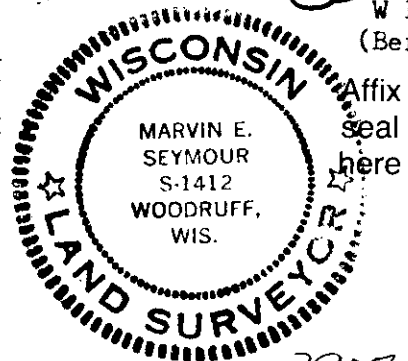

3907030000

E-17