


U.S. PUBLIC LAND SURVEY MONUMENT RECORD

Note: This form is intended and designed to fulfill all requirements of Wisconsin Administrative Code, Chapter A-E 5.02, U.S. Public Land Survey Monument Record (3) (a) (b) (c) (d) (e) (f) (g) (h) (i). An additional sheet may be added if necessary to conform with said requirements.

(a) Corner location: Township 3 9 North
 Range 7 East ~~12~~

Town/Range ~~12~~ of Woodruff

County Oneida

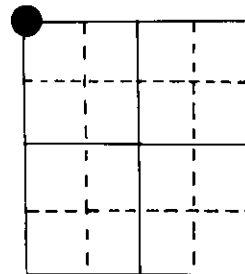

NW cor. Section 16

2" iron pipe with W.C.D. brass cap

(b) (f) (g) (h) Description of monument found at this corner and if it was accepted, state all evidence (material, testimonial, occupational, plats, records, other monuments) used as a basis for accepting. If not accepted or if nothing was found, state evidence used as basis for establishing location. If reestablished through lost corner proportionate methods, indicate all monuments, distances and directions used to establish.

Original Alex Anderson Sept 1863. OBT's Sugar 10" N 26½°W 10 lks, Maple 10" S 7°W 17 lks

Dorr on 12/3/07 found pine stp 30" S 58°E 17 lks.


1950's or

W.C.D pipe that is there now was probably set by Berndt in the 1960's but the records are not to be found. ~~BT'S~~ PW 10" N 2°E 14 lks, PW 14" N 64°E 76 lks

I found W.C.D pipe on 3/29/82 but the B T's on record do not quite match, but distances north, south, east & west check out good using this location. If just the distances from the BT's are used the location does not line to the BT's faces.


BT's I found: PW 18" N 2°E 20.95', dead PW 18" S 55°E 53.10'
 Made new BT's

(c) (d) (e) Plan view of corner with ties to at least 4 witness monuments. If in disagreement with previously established corner, show the distances between the two corners and also indicate the ties to the disputed corner.

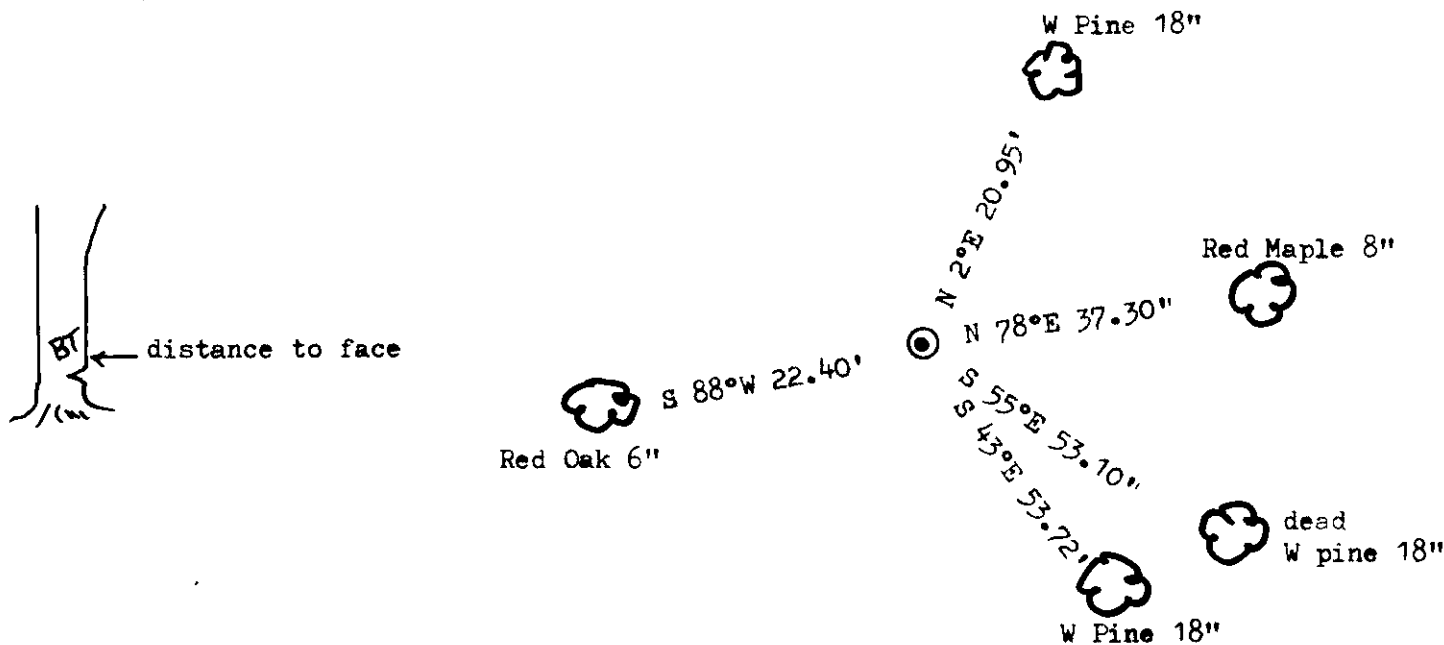

(i) I, Marvin E. Seymour
 (type or print name) certify that the corner location on this record was determined by me or under my direction and control and that this U.S. Public Land Survey Monument Record is correct and complete to the best of my knowledge and belief.

Marvin E. Seymour April 16, 1984
 Signature Date

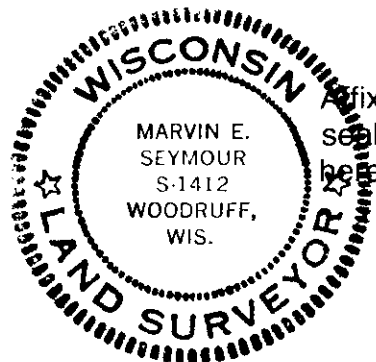

5-9

3907080000