


# U.S. PUBLIC LAND SURVEY MONUMENT RECORD

Note: This form is intended and designed to fulfill all requirements of Wisconsin Administrative Code, Chapter A-E 5.02, U.S. Public Land Survey Monument Record (3) (a) (b) (c) (d) (e) (f) (g) (h) (i). An additional sheet may be added if necessary to conform with said requirements.

(a) Corner location: Township 39 North  
 Range 7 East ~~West~~

Town ~~Oneida~~ of Woodruff

County Oneida

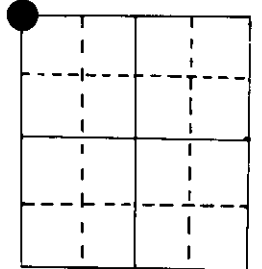

NW cor Section 14

2" iron pipe with W.C.D. brass cap

(b) (f) (g) (h) Description of monument found at this corner and if it was accepted, state all evidence (material, testimonial, occupational, plats, records, other monuments) used as a basis for accepting. If not accepted or if nothing was found, state evidence used as basis for establishing location. If reestablished through lost corner proportionate methods, indicate all monuments, distances and directions used to establish.

Original Alex Anderson Sept 1863. OBT's PW 8" N 56°E 36 lks, BW 10" N 11°W 25 lks


Vaughn on 11/12/01 no sign of orig. cor, set new cor.  
 PW stp 36" S 34°W 0.670 ch, PW stp 28" S 76°E 0.360 ch

Berndt in 4/14/61 found Vaughn's cor. BT by Hassler OR 6" N 83°W 0.355 ch  
 OR 6" S 46°W 0.478 ch

I found WCD pipe in good condition with BT's PW 14" N 88°E 65.45', OR 12" S 53°W 31.40'  
 2/9/83 OR 14" N 86°W 23.80'

Made new BT's Jan 1984  
 OR 12" N 15°W 43.94', PW 12" S 45°E 28.55'

(c) (d) (e) Plan view of corner with ties to at least 4 witness monuments. If in disagreement with previously established corner, show the distances between the two corners and also indicate the ties to the disputed corner.

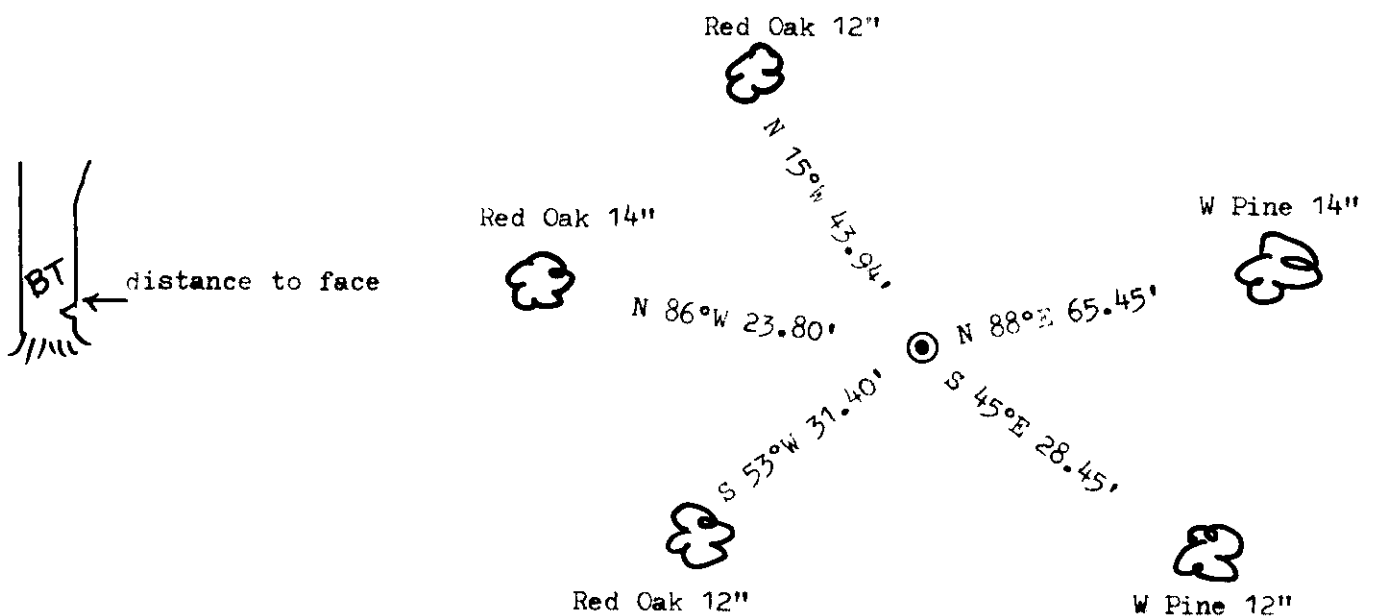

(i) I, Marvin E. Seymour  
 (type or print name) certify that the corner location on this record was determined by me or under my direction and control and that this U.S. Public Land Survey Monument Record is correct and complete to the best of my knowledge and belief.

Marvin E. Seymour April 13, 1984  
 Signature Date



3907100000

5-17