


# U.S. PUBLIC LAND SURVEY MONUMENT RECORD

Note: This form is intended and designed to fulfill all requirements of Wisconsin Administrative Code, Chapter A-E 5.02, U.S. Public Land Survey Monument Record (3) (a) (b) (c) (d) (e) (f) (g) (h) (i). An additional sheet may be added if necessary to conform with said requirements.

(a) Corner location: Township 39 North  
 Range 7 East ~~4~~  
 Town/Range of Woodruff  
 County Oeida  
 2" iron pipe, in water

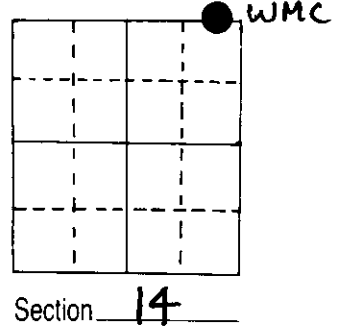


(b) (f) (g) (h) Description of monument found at this corner and if it was accepted, state all evidence (material, testimonial, occupational, plats, records, other monuments) used as a basis for accepting. If not accepted or if nothing was found, state evidence used as basis for establishing location. If reestablished through lost corner proportionate methods, indicate all monuments, distances and directions used to establish.

Original Alex Anderson Sept 1863. OBT's BW 8" S 81°E 25 lks, Spruce 8" N 10°W 37 lks at 35.90 ch ea st of 1/4 cor.

J. Griffin shows on map dated June 1971 the 2" i.p. in lake.  
 BT's 16" Oak S 88°W 7.2', 12" Oak N 45°W 14.4', erroneous M.C. south 266.0' (Berndt's)


I found on 2/8/83 the erroneous MC and the correct location 2" I.P. in water.  
 The erroneous pipe will be removed in the summer of 1984 after the frost is out.  
 Made BT's in Feb. 1984: PW 2" S 37°W 17.75', BW 10" S 54°W 16.53'  
 OR 4" N 6°W 13.74' old BT OR 16" N 31°W 14.58'

(c) (d) (e) Plan view of corner with ties to at least 4 witness monuments. If in disagreement with previously established corner, show the distances between the two corners and also indicate the ties to the disputed corner.

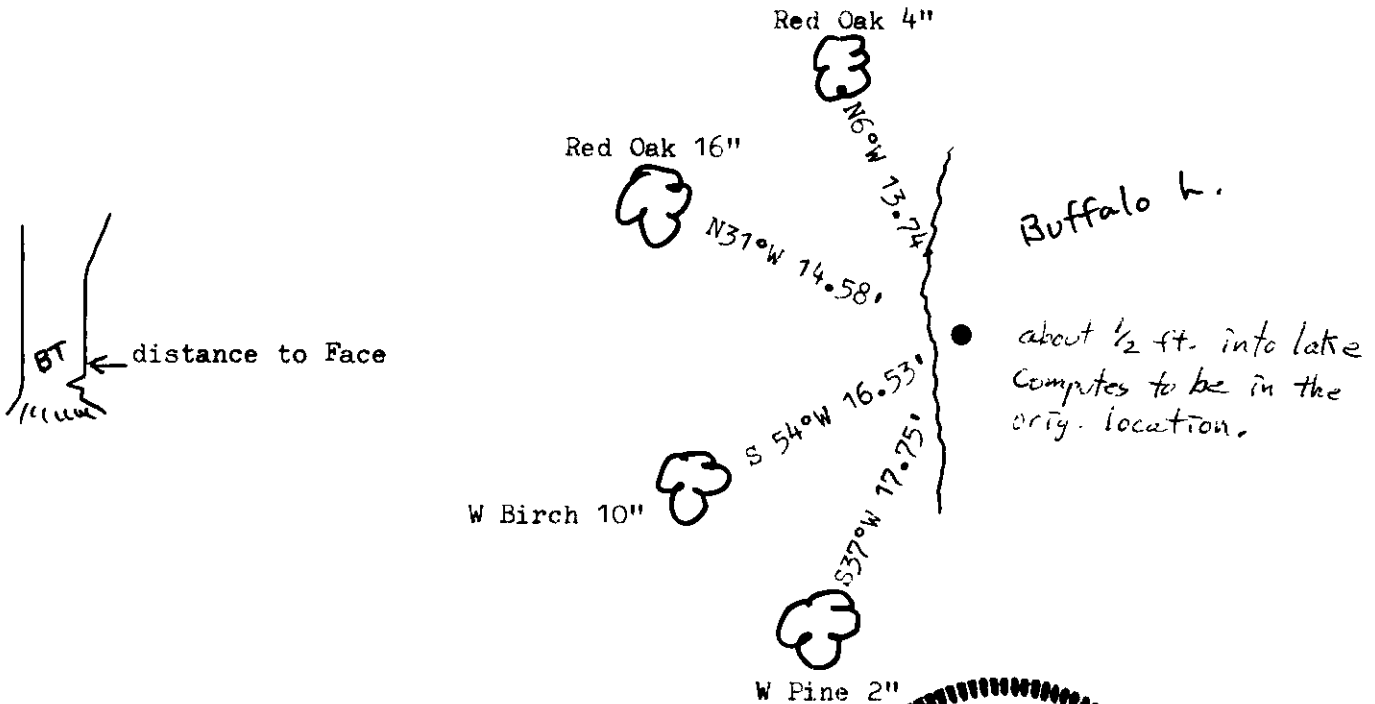

(i) I, Marvin E. Seymour  
 (type or print name) certify that the corner location on this record was determined by me or under my direction and control and that this U.S. Public Land Survey Monument Record is correct and complete to the best of my knowledge and belief.

Marvin E. Seymour April 13, 1984  
 Signature Date

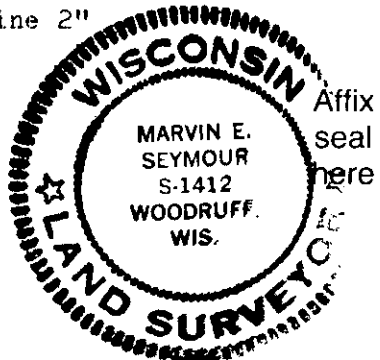

5-21

3907/10005