


U.S. PUBLIC LAND SURVEY MONUMENT RECORD

Note: This form is intended and designed to fulfill all requirements of Wisconsin Administrative Code, Chapter A-E 5.02, U.S. Public Land Survey Monument Record (3) (a) (b) (c) (d) (e) (f) (g) (h) (i). An additional sheet may be added if necessary to conform with said requirements.

(a) Corner location: Township 39 North
 Range 7 East ~~11~~
 Town ~~Oneida~~ of Woodruff
 County Oneida
 2" iron pipe with W.C.D. brass cap

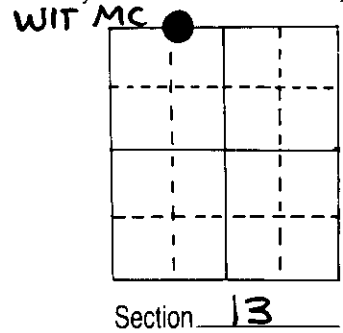

(b) (f) (g) (h) Description of monument found at this corner and if it was accepted, state all evidence (material, testimonial, occupational, plats, records, other monuments) used as a basis for accepting. If not accepted or if nothing was found, state evidence used as basis for establishing location. If reestablished through lost corner proportionate methods, indicate all monuments, distances and directions used to establish.


Original Alex Anderson Sept 1863. OBT's PY 6" S 57°E 19 lks, PY 6" N 43°E 21 lks at 60.00 ch west of NE cor.

H. Hall in 10/12/31 found orig. M.C., both OBT's & point for MC in water.
 Set witness cor. 16 lks east of orig. point.
 BT's to Wit. PN 6" N 9°E 1.180 ch, PN 9" S 20°E 0.670 ch.

Berndt in 4/17/61 found Hall's witness cor. & set W.C.D. pipe Witness cor. at
 0.263 ch east of Hall's & 0.423 ch east of orig. MC. BT's to new Wit
 PN 11" S 23°E 0.310 ch
 PN 10" N 68°E 0.355 ch

I found WCD pipe on 3/19/82 and made new BT's in Feb. 1984 PW 15" North 11.00'
 PW 4" S 50°W 4.62'

(c) (d) (e) Plan view of corner with ties to at least 4 witness monuments. If in disagreement with previously established corner, show the distances between the two corners and also indicate the ties to the disputed corner.

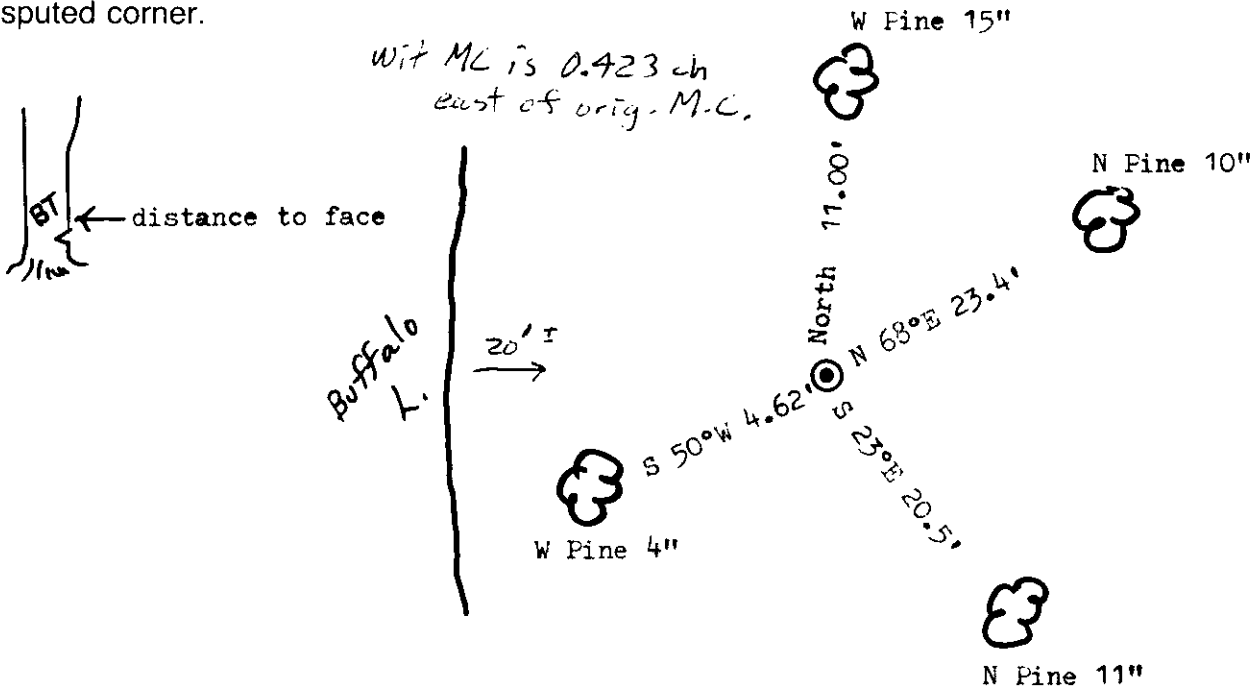

(i) I, Marvin E. Seymour
 (type or print name) certify that the corner location on this record was determined by me or under my direction and control and that this U.S. Public Land Survey Monument Record is correct and complete to the best of my knowledge and belief.

Marvin E. Seymour April 12, 1984
 Signature Date



3907120029

5-22