


U.S. PUBLIC LAND SURVEY MONUMENT RECORD

Note: This form is intended and designed to fulfill all requirements of Wisconsin Administrative Code, Chapter A-E 5.02, U.S. Public Land Survey Monument Record (3) (a) (b) (c) (d) (e) (f) (g) (h) (i). An additional sheet may be added if necessary to conform with said requirements.

(a) Corner location: Township 39 North
 Range 7 East ~~14~~
 Town/ ~~Galena~~ of Woodruff
 County Oneida

EMC

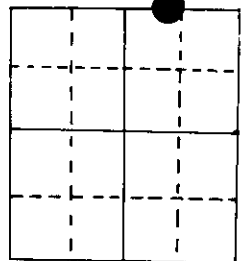

Section 24

2" iron pipe with W.C.D. brass cap


(b) (f) (g) (h) Description of monument found at this corner and if it was accepted, state all evidence (material, testimonial, occupational, plats, records, other monuments) used as a basis for accepting. If not accepted or if nothing was found, state evidence used as basis for establishing location. If reestablished through lost corner proportionate methods, indicate all monuments, distances and directions used to establish.

Original Alex Anderson Sept 1863. OBT's B Oak 8" S 29°E 7 lks, BW 8" N 47°E 20 lks at 19.72 ch west of NE 24.

Berndt in 7/8/60 found point of old post., Made BT's PN 20" S 70°E 24 lks
 OJ 18" N 28°E 13 lks

I found on 3/24 82 wcd pipe & BT's. Made new BT MR 4" S 21°W 27.15'
 ON 6/4/84 made BT's MH 10" N 72°E 23.1'
 OR 12" S 32°E 13.1'

(c) (d) (e) Plan view of corner with ties to at least 4 witness monuments. If in disagreement with previously established corner, show the distances between the two corners and also indicate the ties to the disputed corner.

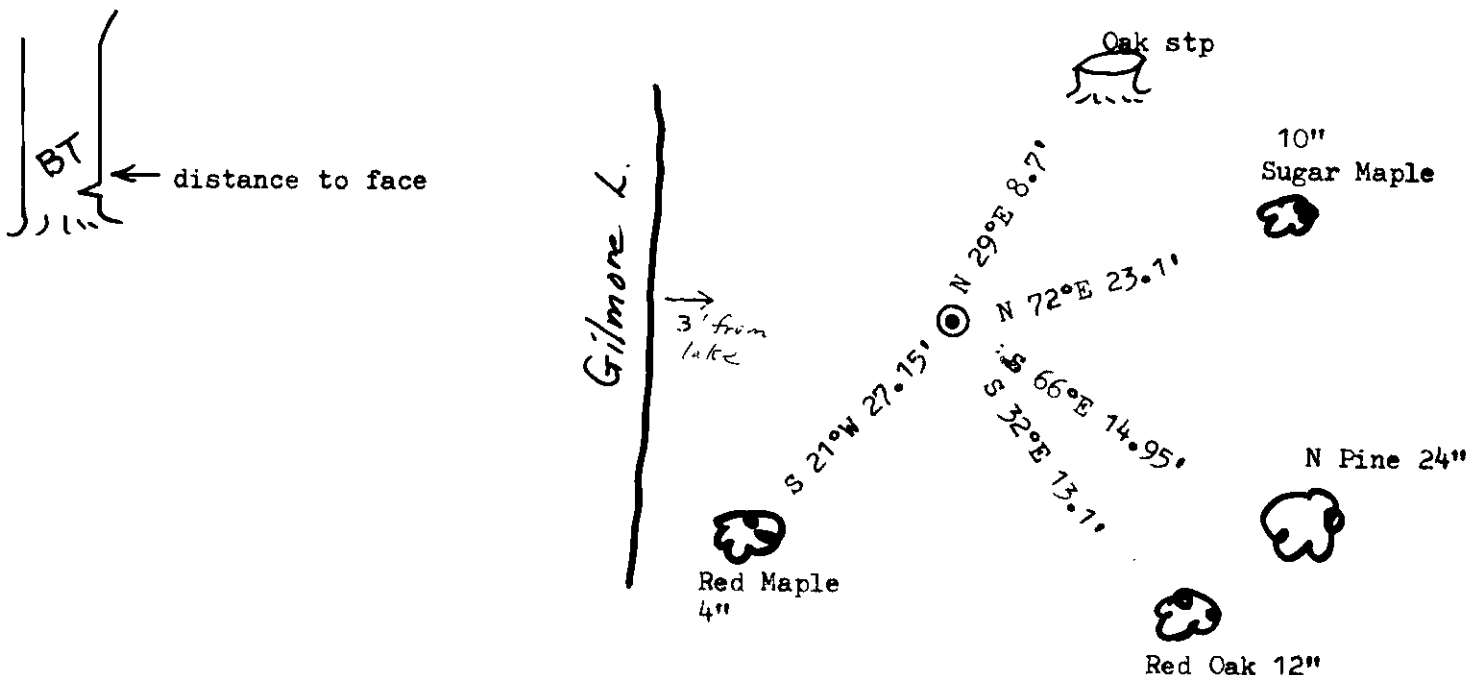

(i) I, Marvin E. Seymour
 (type or print name) certify that the corner location on this record was determined by me or under my direction and control and that this U.S. Public Land Survey Monument Record is correct and complete to the best of my knowledge and belief.

Marvin E. Seymour June 5, 1984
 Signature Date



3907130011

N-24