

# U.S. PUBLIC LAND SURVEY MONUMENT RECORD


Note: This form is intended and designed to fulfill all requirements of Wisconsin Administrative Code, Chapter A-E 5.02, U.S. Public Land Survey Monument Record (3) (a) (b) (c) (d) (e) (f) (g) (h) (i). An additional sheet may be added if necessary to conform with said requirements.

(a) Corner location: Township 39 North

Range 7 East ~~3~~

Town ~~Springfield~~ of Woodruff

County Oneida

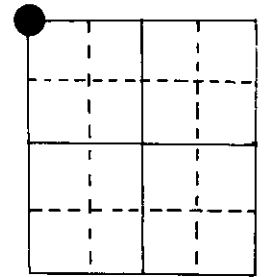

NW cor. Section 24

2" iron pipe with W.C.D. brass cap

(b) (f) (g) (h) Description of monument found at this corner and if it was accepted, state all evidence (material, testimonial, occupational, plats, records, other monuments) used as a basis for accepting. If not accepted or if nothing was found, state evidence used as basis for establishing location. If reestablished through lost corner proportionate methods, indicate all monuments, distances and directions used to establish.

Original Alex Anderson Sept 1863. OBT's Spruce 10" S 60°W 5 lks, Spruce 10" N 80°E 20 lks.



Vaughn on 8/7/13 found NW 24 with both OBT stps. Made new BT Pine 40 N 81°E 64 lks.

W.C.D. brass cap and B T's PN 12" S 59°E 96 lks, PN 10" S 1°E 64 lks.  
 Stamped 1955, probably set by Berndt.

Hall on 10/3/31 found Vaughn's 40" pine BT and cor. Other BT's Spruce 8" N 26°W .118 ch  
 Spruce 7" S 22½°W .21 ch

I found on 3/23/82 the W.C.D. pipe and BT's PN 12" N 54°W 63.35'  
 PN 10" S 1°E 42.25' Made two more BT's.

(c) (d) (e) Plan view of corner with ties to at least 4 witness monuments. If in disagreement with previously established corner, show the distances between the two corners and also indicate the ties to the disputed corner.

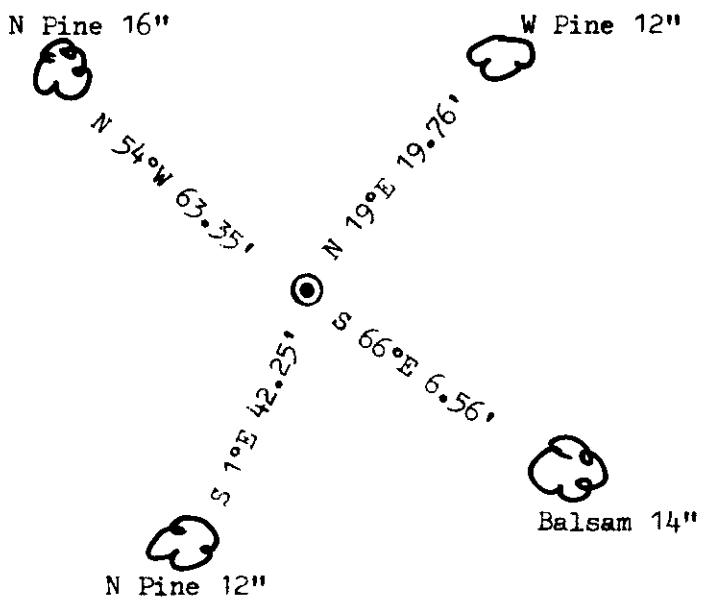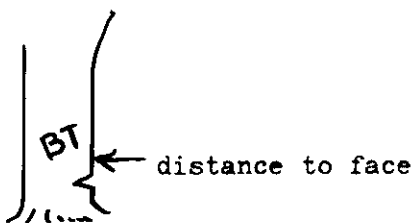

(i) I, Marvin E. Seymour  
 (type or print name) certify that the corner location on this record was determined by me or under my direction and control and that this U.S. Public Land Survey Monument Record is correct and complete to the best of my knowledge and belief.

Marvin E. Seymour April 20, 1984  
 Signature Date



3907140000