


U.S. PUBLIC LAND SURVEY MONUMENT RECORD

Note: This form is intended and designed to fulfill all requirements of Wisconsin Administrative Code, Chapter A-E 5.02, U.S. Public Land Survey Monument Record (3) (a) (b) (c) (d) (e) (f) (g) (h) (i). An additional sheet may be added if necessary to conform with said requirements.

(a) Corner location: Township 39 North
 Range 7 East ~~West~~
 Town/~~City/Village~~ of Woodruff
 County Oneida

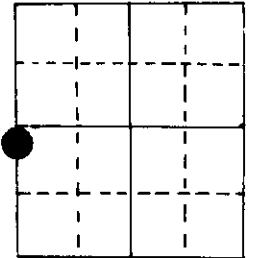

Witness W 1/4 Section 13

2" iron pipe with W.C.D. brass cap

(b) (f) (g) (h) Description of monument found at this corner and if it was accepted, state all evidence (material, testimonial, occupational, plats, records, other monuments) used as a basis for accepting. If not accepted or if nothing was found, state evidence used as basis for establishing location. If reestablished through lost corner proportionate methods, indicate all monuments, distances and directions used to establish.


Original Alex Anderson Sept 1863. OBT's to witness cor 50 lks south of true cor.
 Tam 6" S 15°E 39 lks
 Tam 6" N 63°W 13 lks

Dorr on 10/31/1898 found both OBT's & orig. stake for witness cor.

Berndt on 3/23/60 set W.C.D. pipe for witness cor 1,100 ch south of true cor.
 Made BT's Tam 4" N 34°W 1,020 ch, Tam 4" S 13°W 2,170 ch

I found WCD pipe and BT's on 3/23/82. Pipe is in open marsh area and no other trees around within 1500'.

(c) (d) (e) Plan view of corner with ties to at least 4 witness monuments. If in disagreement with previously established corner, show the distances between the two corners and also indicate the ties to the disputed corner.

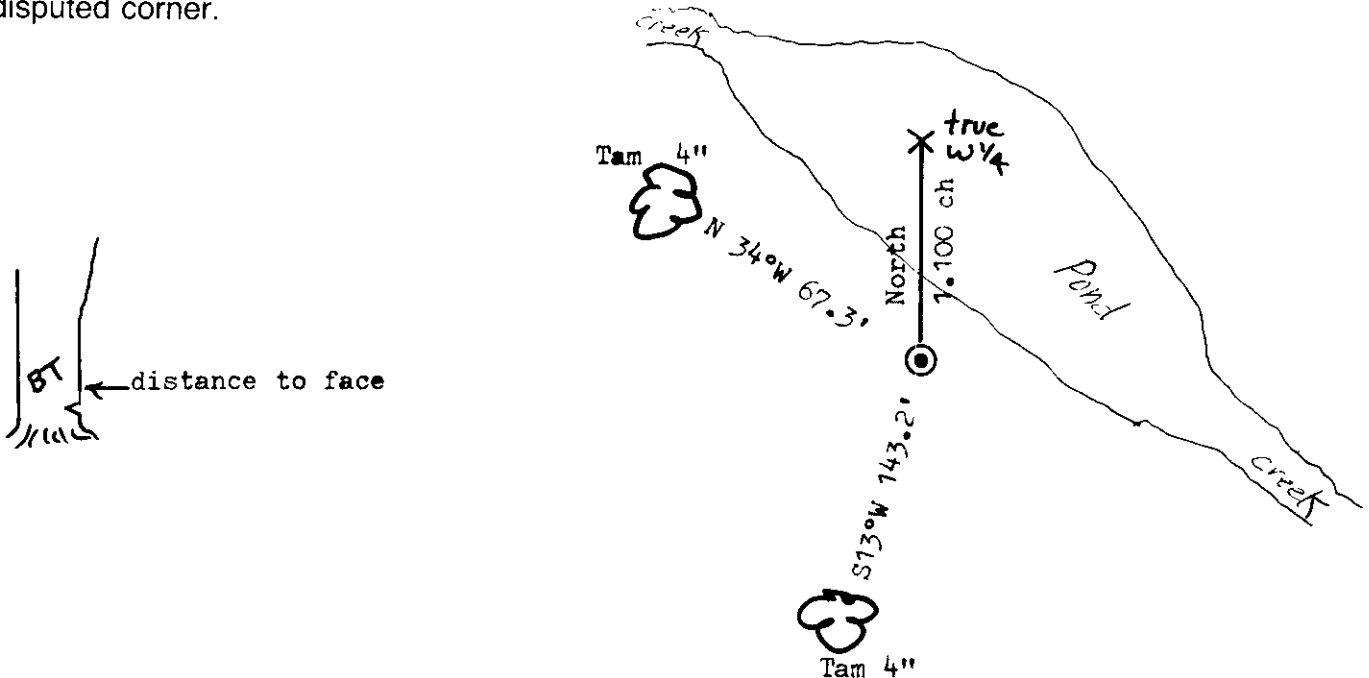

(i) I, Marvin E. Seymour
 (type or print name) certify that the corner location on this record was determined by me or under my direction and control and that this U.S. Public Land Survey Monument Record is correct and complete to the best of my knowledge and belief.

Marvin E. Seymour April 13, 1984
 Signature Date



3907141900

LJM-21